


RICE

Form 51—5M—3-35—Mid-West

Map No. KANSAS Sec. 16 Twp. 20 R. 9-W

Well No. 5-Smith Farm
Gulf Oil Company

NORTH

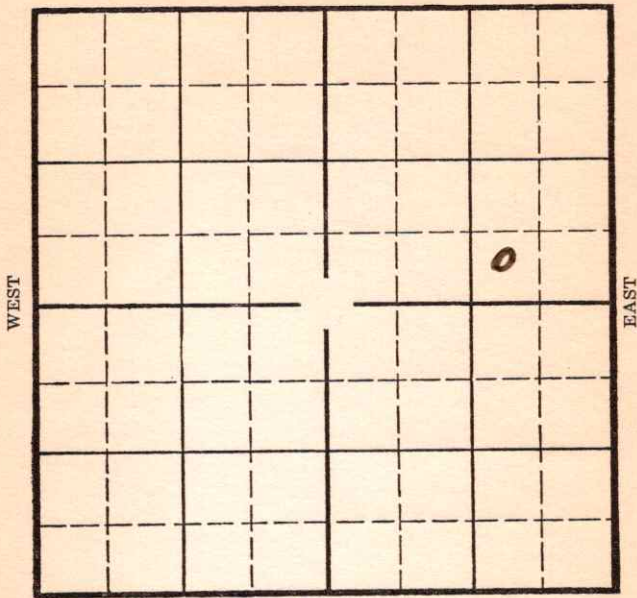

SOUTH

Location_____

Drilling Remarks

Rig Up-----

Drilling Remarks

RECORD

Cased..... in..... ft.

Sand

Gas_____

Oil

Total Depth.....

PRODUCTION

1st 24 hrs. Nat.

1st 24 hrs. after shot_____

Gas.....cu. ft.....

Dry Hole.....

Abandoned_____

Map No. Sec. 16 Twp. 20 R. 9W
Well No. 5-Smith Farm
Gulf Oil Company

 Ft. from N. Line

330 Ft. from S. Line

990 Ft. from E. Line

 Ft. from W. Line

Elev. 1716

NORTH									
								0	
SOUTH									

REPORT

~~1936~~
3/11 Regr
3/20 10"-187 Drlg. 1550
3/27 T.D. 3079 Fishing pipe.
4/2 T.Sil. 3233' 7"- 3233' T.D. 3236'
Rigging up standard tools.
4/10 T.D. 3254' Ream hole.
4/16 383 oil 18 hours.
4/22/36- **Sil 3233'**
T.D. 3256'
1000 acid.
707 bbls oil.
20 bbls water.

COMPLETED

KANSAS

Map No. 49 Sec. 16 Twp. 20 R. 9W

Well No. 5-Smith

Sulf oil Company

Contractor

FIRST REPORTS

Ft. from N. Line

330 Ft. from S. Line

990 Ft. from E. Line

Ft. from W. Line

SECTION PLAT

			0

Location

Rig up

Drilling and Remarks:

Rgn

RECORD

Cased in., ft.

Sand

Gas

Oil

Total Depth

PRODUCTION

1st 24 hrs. Nat.

1st 24 hrs. after shot

Gas Cu. Ft.

Dry Hole

Abandoned

Date

ORVAL MANNSCHRECK

3-11-36

192

Scout

KANSAS

Map No. 49 Sec. 16 Twp. 20 R. 9WWell No. 5 SmithGulf Company

Contractor

SECTION PLAT

			0

Ft. from N. Line

330 Ft. from S. Line990 Ft. from E. Line

Ft. from W. Line

COMPLETED

Location

Rig up

Drilling and Remarks:

Sil 82331000 acid7078 ft oil20 " water

RECORD

Cased.....in.,ft.

Sand.....

Gas.....

Oil.....

Total Depth 3256

PRODUCTION

1st 24 hrs. Nat.....

1st 24 hrs. after shot.....

Gas.....Cu. Ft.

Dry Hole.....

Abandoned.....

Date

APR 22 1936

192

S. J. LEWIS

Scout