


Section 17 Township 20 Range 9-W

Well Number #1 Coldwater "B"

Company Empire

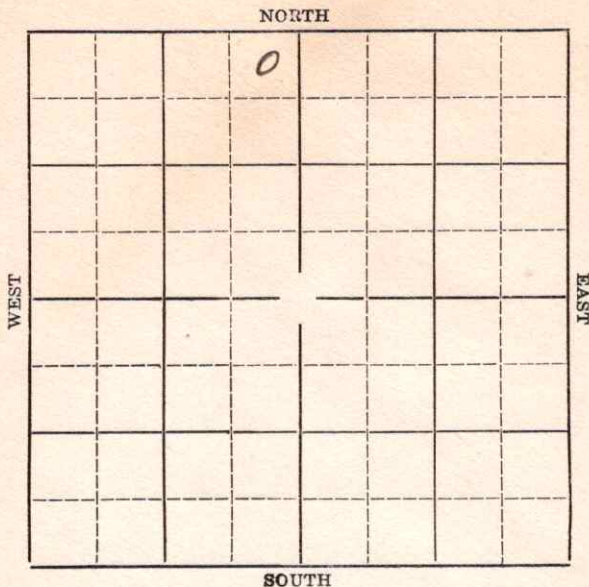


Sec. 17 Twp. 20 R. 9W

Well No. #1 Coldwater "B" Farm

Empire Company

NORTH

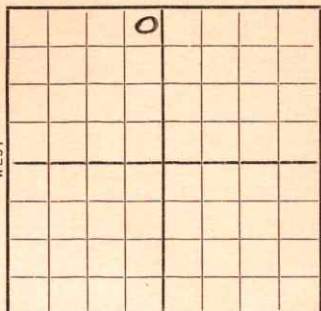

SOUTH

330' Ft. from N. Line

_____ Ft. from S. Line

330' Ft. from E. Line

_____ Ft. from W. Line

Elev. 1743

~~D236~~

REPORT

9/23 Rig.

10/1 Rigging up.

10/8 10" @ 226'. Drlg. 2458'.

10/15 Drlg. 2610'.

10/22 Sil. 3271'. 7" @ 3272' WOC.

10/29 TD 3285'. 2000 gallons of acid.

No test.

11/4 Sil 3271

2000 acid

Total Depth 3285

Pot. 707

COMPLETED

KANSAS

Map No. 49 Sec. 17 Twp. 20 R. 9W

Well No. 1 Coldwater "B"

Empire Company

Contractor

SECTION PLAT

330 Ft. from N. Line

_____ Ft. from S. Line

330 Ft. from E. Line

_____ Ft. from W. Line

	0		

FIRST REPORT

Location _____

Rig up _____

Drilling and Remarks:

Rig

RECORD

Cased _____ in., _____ ft.

Sand _____

Gas _____

Oil _____

Total Depth _____

PRODUCTION

1st 24 hrs. Nat. _____

1st 24 hrs. after shot _____

Gas _____ Cu. Ft.

Dry Hole _____

Abandoned _____

Date

SEP 23 1936

19

S. J. LEWIS

Scout

KANSASMap No. 49 Sec. 17 Twp. 20 R. 9WWell No. 1 Coldwater "B"Empire

Company

Contractor

SECTION PLAT

		0		

330 Ft. from N. Line

_____ Ft. from S. Line

330 Ft. from E. Line

_____ Ft. from W. Line

COMPLETED

Location _____

Rig up _____

Drilling and Remarks:

8132712000 acidPO 707**RECORD**

Cased _____ in., _____ ft.

Sand _____

Gas _____

Oil _____

Total Depth 328.5**PRODUCTION**

1st 24 hrs. Nat. _____

1st 24 hrs. after shot _____

Gas _____ Cu. Ft.

Dry Hole _____

Abandoned _____

Date

NOV 4 1936 19S. J. LEWIS Scout