


Section 25 Township 31 Range 3 E

Well No. # 1 Bonewell

Company Laura Jane & Parker

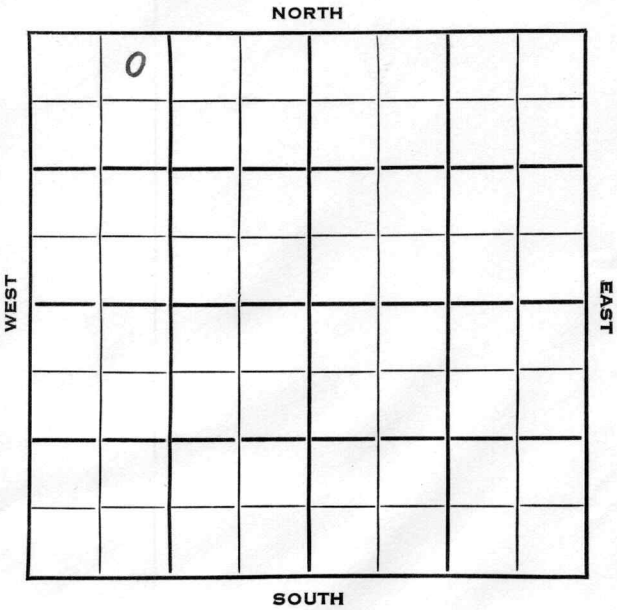

Cowley

KANSAS


SEC.	TWP.	R.
25	31	3 E ✓

WELL NO. # 1 Bonewell FARM

COMPANY Laura Jane & Parker

CONTRACTOR

330 Ft. from N. Line  
 Ft. from S. Line  
 Ft. from E. Line  
 990 Ft. from W. Line

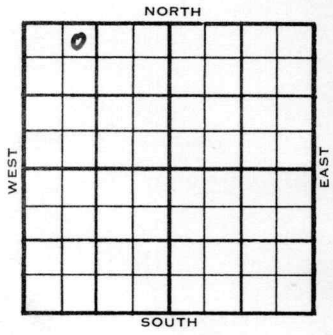

NE NW NW

1953	ELEVATION	REPORT
	-	

10/14 Spud 10-7-53  
 8" @ 90  
 Drlg. 2168'

10/21 Spud 10-7-53  
 D & A  
 TD 3025'  
 8" @ 90'  
 Stal. 2005', Layton 2258, KC 2438'  
 TD 3025'  
 D & A

**ABANDONED**

County **Cowley** State **Kansas**

Sec. **25** (Blk.) **31** (Sur. Rge.) **3E** Map No.

Operator **Laura Jane & Parker**

Well No. **1** Farm **Bonewell**

Elev. Location **NE NW NW**

0					

**330** Ft. From **N** Line **NW**

**990** Ft. From **W** Line **Quarter**

1st. Report **OCT 14 1953**

Completion

Remarks

Spudding Date **10-7-53**

Drlg. Data **8" @ 90 drlg. 2168**

J. G. MCGEHEE

County Cowley State Kansas

Sec. 25 (Blk. 31) (Sur. 3E) (Twp. Rge.) Map No.

Operator Laura Jane & Parker

Well No. 1 Farm Bonewell

Elev. \_\_\_\_\_ Location NE NW NW

0					
ABANDONED					

330 Ft. From N Line NW

990 Ft. From W Line Quarter

1st. Report

Completion OCT 21 1953

Remarks

Spudding Date 10-7-53

Drig. Data D & A TD 3025

8" @ 90 Stal. 2005 Layton 2258

KC 2438 TD 3025

D & A