


Section 26 Township 31 Range ~~4~~ 3E

Well No. #1 Smith

Company Prairie O. & G.

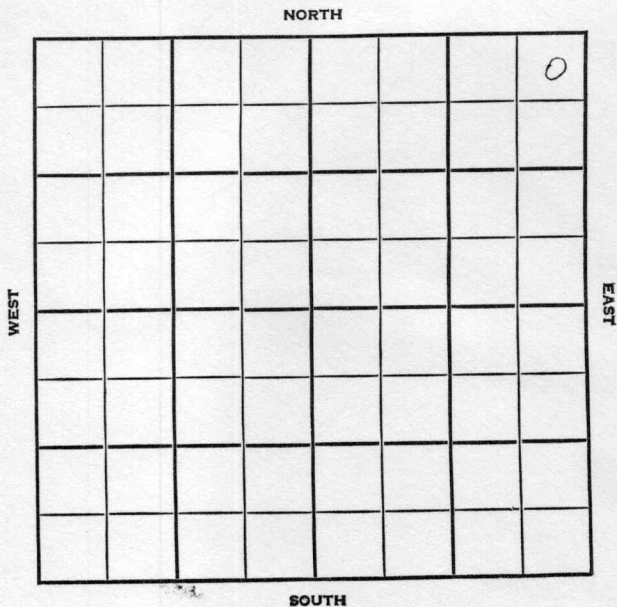

Cowley

KANSAS

SEC. 26	TWP. 31	R. 4E 2E
------------	------------	------------------------

WELL NO. #1 Smith FARM

COMPANY Prairie O & G

CONTRACTOR


WILDCAT

330 FT. FROM N. LINE

FT. FROM S. LINE

500 FT. FROM E. LINE

FT. FROM W. LINE

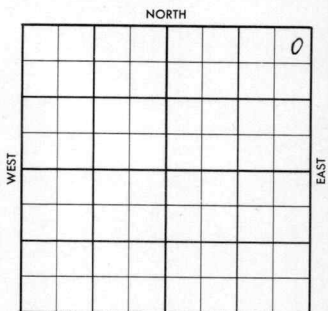

NE NE NE

P. P. - FO

1956	ELEVATION 1196'	REPORT
------	--------------------	--------

6-13 Comm. 7-7-56
8" @ 130 w/160
Drlg. 1220

7-11 5 1/2" @ 2979
CO 2994
tst 50 GW in 25 min.
Frac FU 1000' wtr., 14 hrs.
CO 2994
DD 3000'
Cave In.
D & A
L. 2038'; KC. 2418'; BKC 2694';
Marm 2753'; Ce. 2861'; Bartl 2977';
TD 3000'

ABANDONED

County Cowley Elev. _____
 Sec. 26 Twp. 31 Rge. 4E
 Company Prairie O & G
 Farm Name Smith No. 1

TOPS	DEPTH	LOG	DATUM
Anh.			
Tp.			
H.			
Tr.			
Dg.			
Bl.			
L.			
K.C.			
B.K.C.			
Ce.			
C.			
M.			
M.			
K.			
Mz.			
Me.			
V.			
S.			
S.			
A.			
R.			
PE.			
G.			
T.D.			

Loc. in Sec. _____
NE NE NE
330' NL
500' EL
 Geol. _____
 Contr. _____
 Pool Wildcat

FIRST REPORT

JUN 3 '55

Date Comm. 7-7-56 P.P. - FO

8" @ 130/160 drlg. 1220

7M S. O. 1022

29

Co.
Lse.
No.
Sec.
T.
R.

CORRECTION

FORM 513 SUNRAY

County Cowley Elev. 1196
 Sec. 26 Twp. 31 Rge. 3E
 Company Prairie O & O
 Farm Name Smith No. 1

TOPS	DEPTH	LOG	DATUM	Loc. in Sec.
Anh.				NE NE NE
Tr.				330' NL
Dg.				500' BL
Bl.				
L.	2078			Geol.
K.C.	2418			Contr.
B.K.C.	2694			
Ce.	Marm 2753			
C.	ce 2861			
M.	BoH 2977			
M.				Pool
K.				Wildest
Mz.				
Me.				
V.				
S.				
S.				
A.				
R.				
PE.				
G.				
ID.	2994	2992		ABANDONED JUL 1 1 1956

Date Comm. 7-7-56 P.P. - FO
8" @ 130/160 dnl. .1220 JUN 20 '56 JUN 27 '56

5 1/2 2979 MICT CO 2994 1st
50 GW in 25" (Rainbow 500)
JUL 3 '56 Frac FU 1000' wtr (550)
14 hrs JUL 11 '56 CO 2994 DP
3000 cave in

DEA