

KANSAS

Rice


FORM 51 5M 10-41 PETROL

Section 17 Township 20 Range 9-W

Well No. #1 McGlyn

Company Cities Service Oil

NORTH Keesling Pool

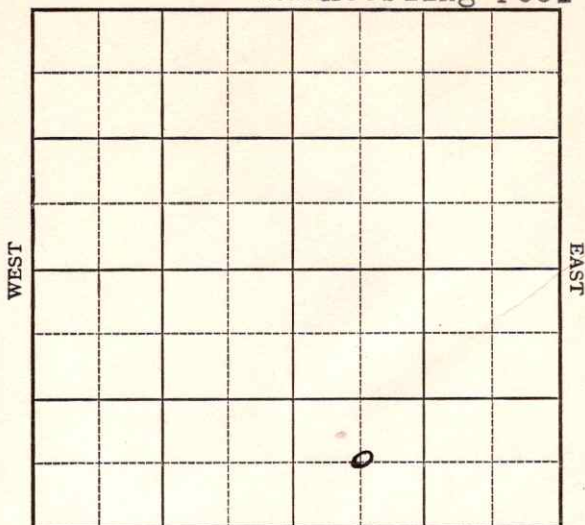

SOUTH

Sec. 17 Twp. 20 R. 9-WWell No. #1 McGlyn Farm

Cities Service Oil Company

(Keesling Pool)

Ft. from N. Line

660


Ft. from S. Line

Ft. from E. Line

660

Ft. from W. Line

Elev. 1774

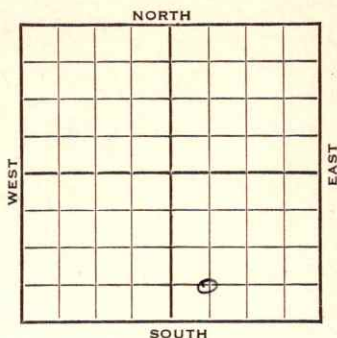

1942

REPORT

7/22

Drlg. 65'

7/29

8" - 249

Drlg. 2490'

8/5

Drlg. 3308'

8/12

Anhy 370 Lans 2995 BKC 3272
 Simp 3310 Arb ~~3310~~ TD 3324,
 4" @ 3319 Rust

8/19

Arb. 3310 (Corrected)

4" - 3315

T.D. 3318

Pump 60 oil in 6½ hrs.

8/27

Arb. 3310

4" - 3315

500 acid

Pump 45l Pot.

T.D. 3318

Gravity 44.5

COMPLETED

Rice

Map No. 49 Sec. 17 Twp. 20 R. 9WWell No. 1 McGlynCities Service Oil Company

FIRST REPORT

Contractor

C SW SE

SECTION PLAT

		0	

 Ft. from N. Line660 Ft. from S. Line Ft. from E. Line660 Ft. from W. Line

KEESLING POOL

Location Rig up

Drilling and Remarks:

Drlg. 65'

RECORD

Cased in., ft.Sand Gas Oil Total Depth

PRODUCTION

1st 24 hrs. Nat. 1st 24 hrs. after shot Gas Cu. Ft.Dry Hole Abandoned

Date

JUL 22 1942 19 S. J. LEWIS Scout

KANSAS

Rice

Map No. 49 Sec. 17 Twp. 20 R. 9WWell No. 1 McGlynCities Service Oil CompanyCOMPLETED Contractor

C SW SE

SECTION PLAT

 Ft. from N. Line660 Ft. from S. Line Ft. from E. Line660 Ft. from W. Line

KEESLING POOL

Location Rig up

Drilling and Remarks:

Per 73310
4" C 3315
500 acid
Pump. 45184

RECORD

Cased in., ft.Sand Gas Oil Total Depth 3315

PRODUCTION

1st 24 hrs. Nat. 1st 24 hrs. after shot Gas Cu. Ft.Dry Hole Abandoned

Date

AUG 27 1942

19

S. J. LEWIS

Scout