


Section 28 Township 31 Range 3E

Well No. 1 Ray *(Ray)*

Company W L Hartman

Misc.
NORTH

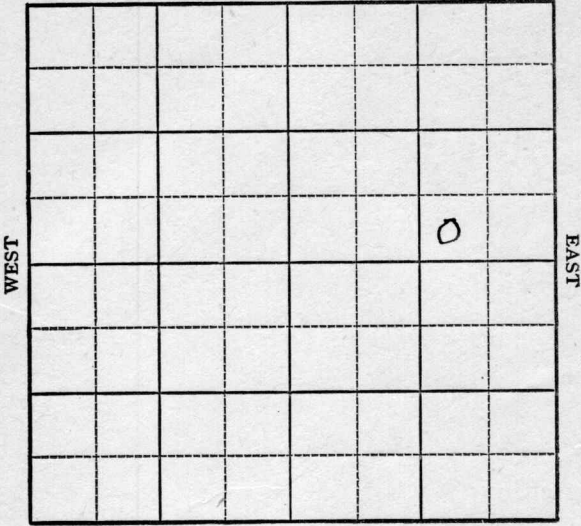

SOUTH

Sec. 28 Twp. 31 R. 3E

Well No. 1 Ray Farm

W.L. Hartman Company

Misc.


 Ft. from N. Line

330 Ft. from S. Line

990 Ft. from E. Line

 Ft. from W. Line

SW SE NE

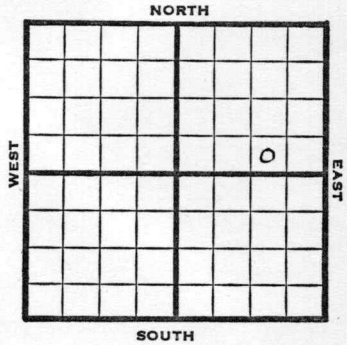

1948 Elev. 1198' REPORT

9/1 Location

9/8 "

9/14 KC 2499 '
Drlg. 2500'

9/29 "

10/6 Arbuckle 3356 '
TD 3401'

ABANDONED

Cowley

County Kansas

State

Map No.

Sec.

28

Twp.

31

R.

3E

Well No.

1 Ray

W. L. Hartman

Company

IRST REPORT

Contractor

SW SE NE

SECTION PLAT

Ft. from N. Line

330

Ft. from S. Line

990


Ft. from E. Line

Ft. from W. Line

Miscellaneous

Remarks:

Location

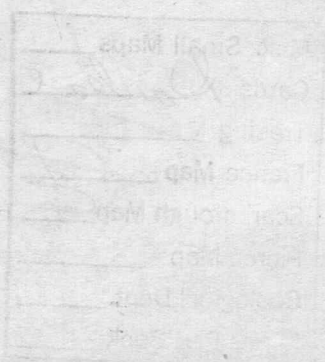

Date

SEP 1 1948

Scout

S. J. LEWIS

Map No. / Sec. 28 Twp. 31 R. 3E

Well No. 1 Ray

W. L. Hartman Company

ABANDONED

Contractor

SW SE NE

E 11198
SECTION PLAT

			6

Ft. from N. Line

330

Ft. from S. Line

990

Ft. from E. Line

Ft. from W. Line

Cowley County

Location _____

Rig up _____

Drilling and Remarks:

cut 3306

RECORD

Cased _____ in., _____ ft.

Sand _____

Gas _____

Oil _____

Total Depth 3401

PRODUCTION

1st 24 hrs. Nat. _____

1st 24 hrs. after shot _____

Gas _____ Cu. Ft.

Dry Hole _____

Abandoned _____

Date

OCT 6 1948

19

S. J. LEWIS

Scout