

KANSAS

Rice

Sec. 17 Twp. 20 R. 9-W

Well No. #2 McGlynn Farm

Cities Service Oil Company


Chase Pool

990 Ft. from N. Line

_____ Ft. from S. Line

990 Ft. from E. Line

_____ Ft. from W. Line

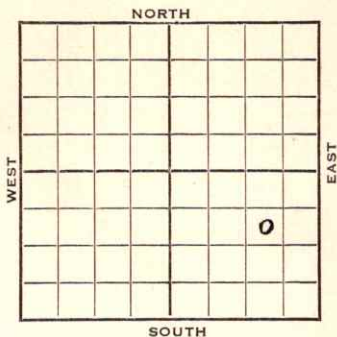

SW NE SE *Elev. 1759*

1942

REPORT

11/24 Loc.

12/2 10" @ 190' dr.g 2527

12/9 Arp 3305-08
TD 7" @ 3307 rust

12/16 **Lans 2971**
Arb 3298
Corrected
7" @ 3300
TD 3307

SSD

12/22 1500 gals. acid.
Pump 68 bbls. oil plus 2% water in
16 hrs.

12/29 "

1943

1/6 **Arb. 3298**
7" - 3300

1500 acid

Pump 372 oil and 3% B.S. Pot.
Gravity 44
T.D. 3307

COMPLETED

KANSAS

Rice

Map No. 49 Sec. 17 Twp. 20 R. 9WWell No. 2 McGlynnCities Service Oil CompanyFIRST REPORT Contractor

SW NE SE

990 Ft. from N. Line Ft. from S. Line990 Ft. from E. Line Ft. from W. Line

SECTION PLAT

			o

CHASE POOL

Location XXXRig up

Drilling and Remarks:

RECORD

Cased in., ft.Sand Gas Oil Total Depth

PRODUCTION

1st 24 hrs. Nat. 1st 24 hrs. after shot Gas Cu. Ft.Dry Hole Abandoned

Date

NOV 24 1942 19S. J. LEWIS Scout

