

KANSAS


Rice

FORM 51 5M PETROL

Section 17 Township 20 Range 9-W

Well No. #2 Coldwater "C"

Company Cities Service Oil

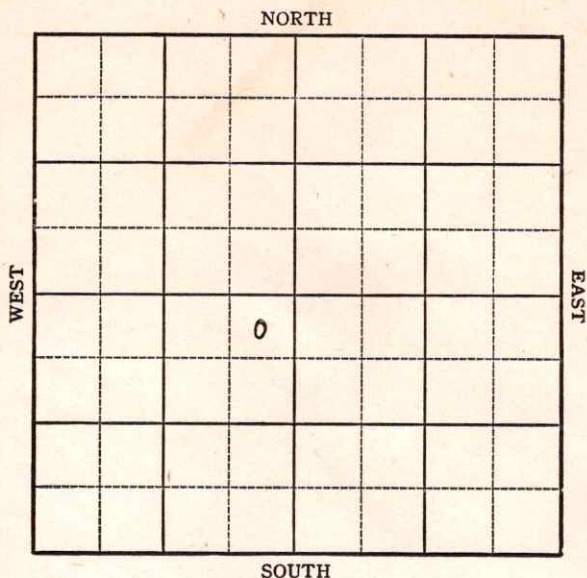

KANSAS


Rice

Sec. 17 Twp. 20 R. 9-W

Well No. #2 Coldwater "C" Farm

Cities Service Oil Company

NORTH

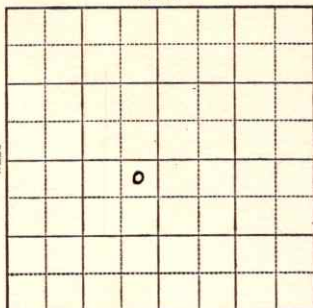

330 Ft. from N. Line

 Ft. from S. Line

330 Ft. from E. Line

 Ft. from W. Line

ELEV. 1761

1943

R E P O R T

9/8

Location

9/15

Rotary

9/22

8" @ 201'
Drlg. 3310'

9/29

Arb 3299
T.D. 3308
5" @ 3299
Rust

10/6

600' oil in 12 hrs, 1000 acid

10/13

Arb 3299
5" @ 3299
1000 acid
Pump 308 Pot.
T.D. 3303
Gravity 42.4

COMPLETED

KANSAS

Map No. 4/9 Sec. 17 Twp. 20 R. 9WWell No. 2 Coldwater "C"

Cities Service Oil

Company

FIRST REPORT

Contractor

NE SW

330 Ft. from N. Line


Ft. from S. Line

330 Ft. from E. Line

Ft. from W. Line

Chase Pool

SECTION PLAT

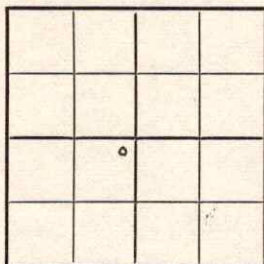Location X

Rig up

Drilling and Remarks:

RECORD

Cased _____ in., _____ ft.

Sand _____

Gas _____

Oil _____

Total Depth _____

PRODUCTION

1st 24 hrs. Nat. _____

1st 24 hrs. after shot _____

Gas _____ Cu. Ft.

Dry Hole _____

Abandoned _____

Date

SEP 8 1943

19

S. J. LEWIS

Scout

KANSAS


Map No. 49 Sec. 17 Twp. 20 R. 9WWell No. 2 Coldwater "C"Cities Service Oil Company

COMPLETED

Contractor

NE SW

SECTION PLAT

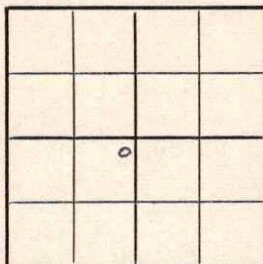330 Ft. from N. Line Ft. from S. Line330 Ft. from E. Line Ft. from W. Line

Chase Pool

Location Rig up

Drilling and Remarks:

*Ar X 0299**5" @ 0299**1000 acid**Pump 308 P.Y.**42 1/2 ft*

RECORD

Cased in., ft.Sand Gas Oil Total Depth 3303

PRODUCTION

1st 24 hrs. Nat. 1st 24 hrs. after shot Gas Cu. Ft.Dry Hole Abandoned

Date

OCT 13 1943

19

S. J. LEWIS

Scout