


Butler

Map No. Sec. 34 Twp. 27 R. 6

Well No. 2 - Shriver Farm

Magnolia Pet Company

NORTH

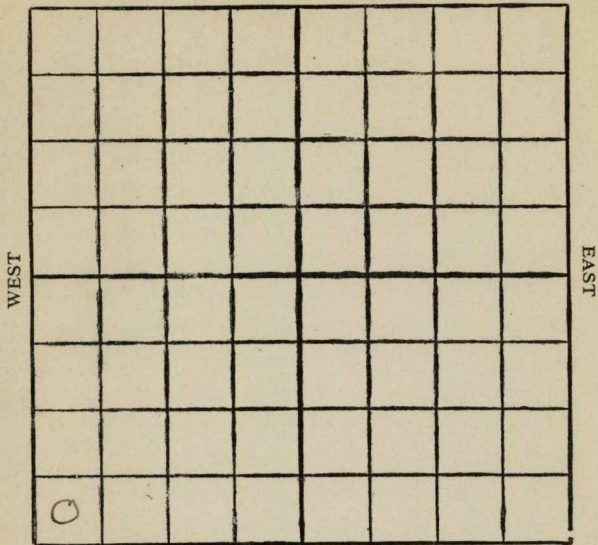

SOUTH

Location .....

Drilling Remarks

Rig Up .....

Drilling Remarks

RECORD

Cased ..... in. .... ft.

Sand .....

Gas .....

Oil .....

Total Depth .....

PRODUCTION

1st 24 hrs. Nat. ....

1st 24 hrs. after shot .....

Gas ..... cu. ft.

Dry Hole .....

Abandoned .....

Butler

Map No. Kansas Sec. 34 Twp. 27 R. 6


Well No. 2 Shriver Farm  
Magnolia Company

\_\_\_\_\_ Ft. from N. Line

330 Ft. from S. Line

\_\_\_\_\_ Ft. from E. Line

330 Ft. from W. Line

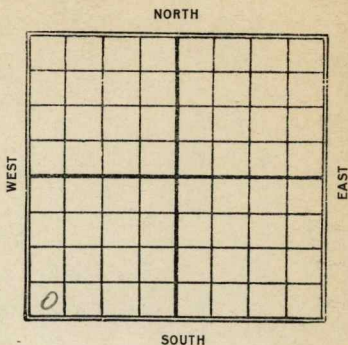

Date	REPORT
1927	
5/25	Bldg Rig
6/11	Rig
6/7	spuz
6/15	Drlg 1050
6/22	" 1800
6/29	" 2500
7/7	Top line 2780
	Drlg 2825
7/13	Sand 3086-
	Drlg 3089 - good show
7/20	Top line 2780
	12 bbb

*Butter*

Map No. *11* **KANSAS** Sec. *34* Twp. *27* R. *6*

Well No. *2* *Shriver*

*Magnolia Pet Co* Company

Contractor

**FIRST REPORTS**

**SECTION PLAT**

----- Ft. from N. Line

*330* Ft. from S. Line

----- Ft. from E. Line

*330* Ft. from W. Line

<i>0</i>			

Location -----

Rig up -----

Drilling and Remarks:

*Blow rig*

**RECORD**

Cased ----- in., ----- ft.

Sand -----

Gas -----

Oil -----

Total Depth -----

**PRODUCTION**

1st 24 hrs. Nat. -----

1st 24 hrs. after shot -----

Gas ----- Cu. Ft.

Dry Hole -----

Abandoned -----

Date

**MAY 25 1927**

**CHAS. L. SHERWOOD**

192

Scout

Butler

11 **KANSAS** Map No. Sec. 34 Twp. 27 R. 6

Well No. 2 Shrewer

Magnolia pet Co Company

Contractor

**COMPLETED**

**SECTION PLAT**

----- Ft. from N. Line

330

----- Ft. from S. Line

----- Ft. from E. Line

330

----- Ft. from W. Line

o			

Location -----

Rig up -----

Drilling and Remarks:

Top line 2780'

12 BS.

**RECORD**

Cased \_\_\_\_\_ in., \_\_\_\_\_ ft.

Sand 3086-3094

Gas -----

Oil -----

Total Depth 3094

**PRODUCTION**

1st 24 hrs. Nat. -----

1st 24 hrs. after shot -----

Gas ----- Cu. Ft.

Dry Hole -----

Abandoned -----

Date

JUL 20 1927

**CHAS. L. SHERWOOD**