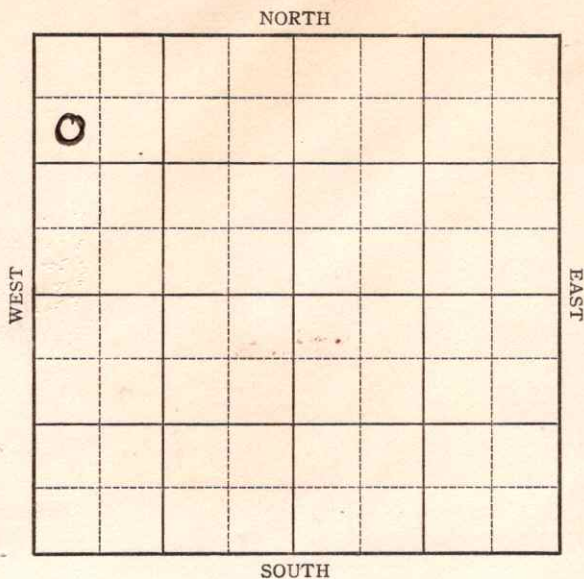


Rice

KANSAS

Section 17 Township 20 Range 9-WWell No. 4 - Coldwater "B"Company Cities Service

KANSAS

Sec. 17 Twp. 20 R. 9-W

Well No. #4 Coldwater "B" Farm

Cities Service Company


990 Ft. from N. Line

_____Ft. from S. Line

_____Ft. from E. Line

330 Ft. from W. Line

Elev. 1757

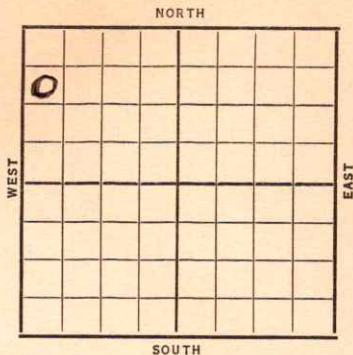[illegible]

Rice **KANSAS**Map No. _____ Sec. 17 Twp. 20 R. 9^WWell No. 4-Coldwater "B"Cities Service Company

FIRST REPORT _____ Contractor

SECTION PLAT

<u>990</u>			

990 Ft. from N. Line1 Ft. from S. Line1 Ft. from E. Line330 Ft. from W. LineLocation ✓

Rig up _____

Drilling and Remarks:

RECORD

Cased _____ in., _____ ft.

Sand _____

Gas _____

Oil _____

Total Depth _____

PRODUCTION

1st 24 hrs. Nat. _____

1st 24 hrs. after shot _____

Gas _____ Cu. Ft.

Dry Hole _____

Abandoned _____

Date

SEP 15 1937 19

H. D. Hatfield Scout

Rice

KANSAS

Map No. 49 Sec. 17 Twp. 20 R. 9WWell No. 4 Coldwater "B"Cities Service Company

Contractor

ABANDONED

SW NE NW

990 Ft. from N. Line Ft. from S. Line Ft. from E. Line330 Ft. from W. Line

SECTION PLAT

<u>0</u>			

Location Rig up

Drilling and Remarks:

#FW

DFA

RECORD

Cased in., ft.Sand 511 3318Gas Oil Total Depth 3331

PRODUCTION

1st 24 hrs. Nat. 1st 24 hrs. after shot Gas Cu. Ft.Dry Hole Abandoned

Date

OCT 13 1937 19

H. D. Hatfield

Scout