


Map No. Kans Sec. 32 Twp. 31 R. 3

Well No. 1 Grant Farm _____
L. A. Murphy Company _____

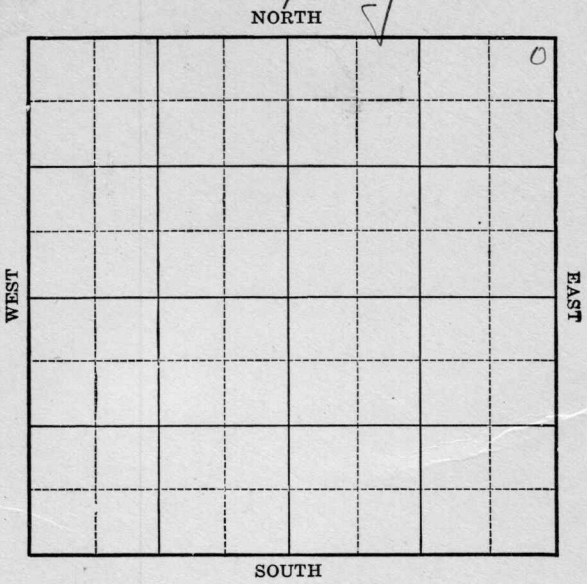

Location _____
Drilling Remarks _____

Rig Up _____
Drilling Remarks _____

RECORD

Cased _____ in. _____ ft.
Sand _____
Gas _____
Oil _____
Total Depth _____

PRODUCTION

1st 24 hrs. Nat. _____
1st. 24 hrs. after shot _____
Gas _____ cu. ft.
Dry Hole _____
Abandoned _____


Map No. Kansas Sec. 32 Twp. 31 R. 3Well No. 1 Grout FarmS. A. Murphy Company300 Ft. from N. Line

Ft. from S. Line

300 Ft. from E. Line

Ft. from W. Line

NORTH

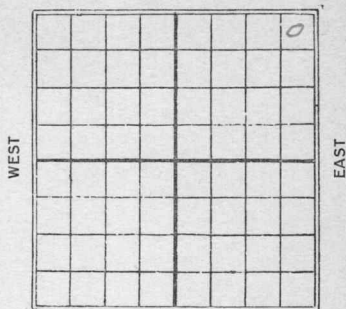

SOUTH

BeneanDate 1925 REPORT

3/24 Location
6/5 setting $15\frac{1}{2}''$ @ 350
7/5 1440
7/22 2250'
7/29 C.O. 2250'
8/7 set 6" 2320' L only 2335'
8/14 2700
8/19 set 6" I.D. 2800
8/27 3055'
9/2 Top Line 3073' L only.
 3215' set 5" @ 3115
9/9 Bottom Line 3320'
 3407 - 3410 N. 7. W
9/16 D. + A. 3537

Map No. 1 **KANSAS** Sec. 32 Twp. 31 R. 3Well No. 1 GrantS. J. Murphy Company

Contractor

FIRST REPORT

SECTION PLAT

300 Ft. from N. Line

_____ Ft. from S. Line

300 Ft. from E. Line

_____ Ft. from W. Line

			0

Location ✓✓

Rig up _____

Drilling and Remarks:

RECORD

Cased _____ in., _____ ft.

Sand _____

Gas _____

Oil _____

Total Depth _____

PRODUCTION

1st 24 hrs. Nat. _____

1st 24 hrs. after shot _____

Gas _____ Cu. Ft.

Dry Hole _____

Abandoned _____

Date

3/24 1925

M. A. BENEAR Scout

MAP NO. _____ SEC. 32 TWP. 31S R. 3EWELL NO. 10000L. H. Murphy et al. COMPANY_____
CONTRACTOR

SECTION PLAT

			0

Ft. FROM N. LINE_____
Ft. FROM S. LINE_____
Ft. FROM E. LINE_____
Ft. FROM W. LINE

LOCATION _____

RIG UP _____

DRILLING AND REMARKS:
OK

RECORD

CASED _____ IN. _____ FT.

SAND _____

GAS _____

OIL _____

TOTAL DEPTH 3537

PRODUCTION

1ST 24 HRS. NAT. _____

1ST 24 HRS. AFTER SHOT _____

GAS _____ CU. FT.

DRY HOLE ✓

ABANDONED _____

DATE

9/15 192 5 _____ SCOUT

Map No. **KANSAS** Sec. 32 Twp. 31 R. 32

Well No. 1 Grant

B. A. Murphy Company

Contractor

SECTION PLAT

300 Ft. from N. Line

_____ Ft. from S. Line

300 Ft. from E. Line

_____ Ft. from W. Line

			0

ABANDONED

Location _____

Rig up _____

Drilling and Remarks:

T. D. 3537 HFW

II & A

RECORD

Cased _____ in., _____ ft.

Sand _____

Gas _____

Oil _____

Total Depth _____

PRODUCTION

1st 24 hrs. Nat. _____

1st 24 hrs. after shot _____

Gas _____ Cu. Ft.

Dry Hole _____

Abandoned _____

Date

SEP 16 1922

S. J. LEWIS

Scout