

KANSAS


FORM 51 5M 10-41 PETROL

Rice

Section 17 Township 20 Range 9-W

Well No. #3 McGlynn "A"

Company Cities Service Oil

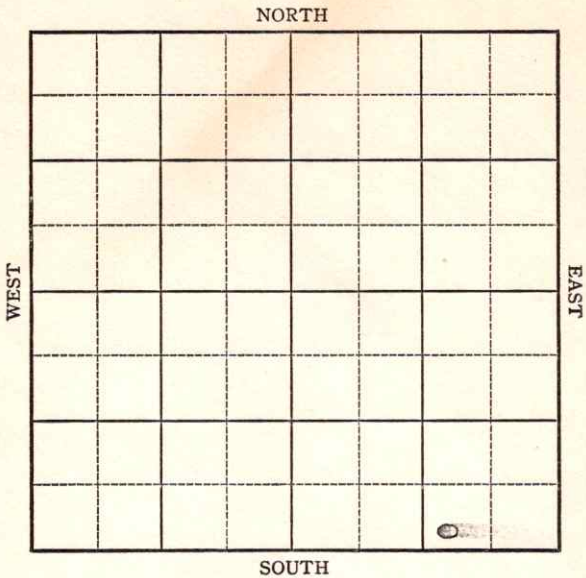

Rice

KANSAS

Sec. 17 Twp. 20 R. 9-W

Well No. #3 McGlynn "A" Farm

Cities Service Oil Company


Chase

 Ft. from N. Line

330 Ft. from S. Line

990 Ft. from E. Line

 Ft. from W. Line

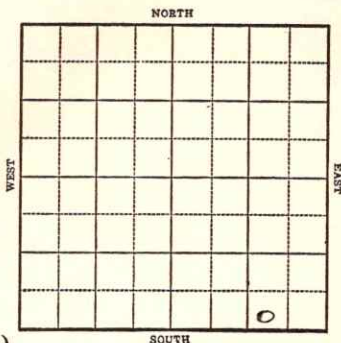

2nd 1758 (est)

1943

R E P O R T

4/7

8" @ 190'

WOC.

4/14

Drilg. 3196'

4/21

Arb 3302

5" @ 3303

T.D. 3306 RUST.

4/28

Arb. 3296

5" @ 3297'

T.D. 3300'

Pump 427 Pot.

Gravity 43.7

COMPLETED

KANSAS

Map No. 49 Sec. 17 Twp. 20 R. 9WWell No. 3 McGlynn "A"Cities Service Oil CompanyFIRST REPORT Contractor

SW SE SE

SECTION PLAT

			o

 Ft. from N. Line330 Ft. from S. Line990 Ft. from E. Line Ft. from W. Line

CHASE POOL

Location Rig up

Drilling and Remarks:

8"-190'

W.O.C.

RECORD

Cased in., ft.Sand Gas Oil Total Depth

PRODUCTION

1st 24 hrs. Nat. 1st 24 hrs. after shot Gas Cu. Ft.Dry Hole Abandoned

Date

APR 7 1943 19S. J. LEWIS Scout

KANSAS

Rice

Map No. 47 Sec. 17 Twp. 20 R. 9WWell No. 3 McGlynn "A"Cities Service Oil Company**COMPLETED**

Contractor

SW SE SE

SECTION PLAT

			0

 Ft. from N. Line330 Ft. from S. Line990 Ft. from E. Line Ft. from W. Line

CHASE POOL

Location Rig up

Drilling and Remarks:

*Cr 83296**5" 83297**Pump 427 P.D.**432 Gr*

RECORD

Cased in., ft.Sand Gas Oil Total Depth 3300

PRODUCTION

1st 24 hrs. Nat. 1st 24 hrs. after shot Gas Cu. Ft.Dry Hole Abandoned

Date

APR 28 1943

19

S. J. LEWIS

Scout