


Section 28 Township 31 Range 3E

Well No. 5 Weathered

Company Bert Frost

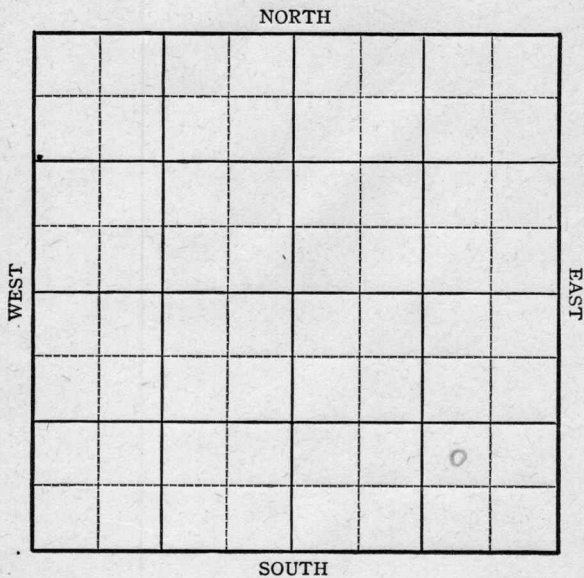

Sec. 28 Twp. 31 R. 3-E

Well No. #5 Weathered Farm


Bert Frost Company

_____ Ft. from N. Line

990 Ft. from S. Line

990 Ft. from E. Line

_____ Ft. from W. Line

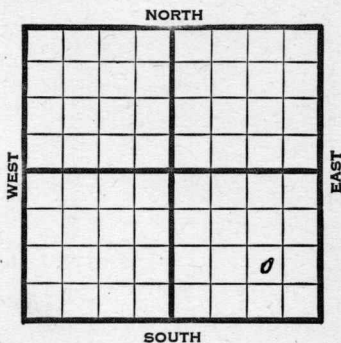

NW SE SE Elev. 1204

1945

REPORT

Date	Location
8/1	Location
8/8	"
8/15	"
8/22	Cable
8/29	20" @ 20
	15" @ 61
	Drlg. 475
9/5	12" @ 755
	10" @ 970
	Drlg. 1550
9/12	8" @ 1758
	Drlg. 1930
9/19	6" @ 1920
9/26	Stal. 2093
	Drlg. 2097
10/3	TD 2097 Run 5"
10/10	5" @ 2091
10/17	5" @ 2081
	TD 2100
	20 qts. 2093-2100 CO
10/24	" " " " "
10/31	" " " " "
11/7	Slat 2085
	5" @ 2091
	20 qts.
	TD 2100
	Pump 50 Pot.
	Grav. 37.0

COMPLETED

KANSAS

Kansas Pool Name Miscellaneous

Map No. 7 Sec. 28 Twp. 31 R. 3E

Well No. 5 Weathered

Bert Frost Company

FIRST REPORT Contractor

NW SE SE

SECTION PLAT

 Ft. from N. Line

990 Ft. from S. Line

990 Ft. from E. Line

 Ft. from W. Line

			o

Cowley County

Location X

Rig up

Drilling and Remarks:

RECORD

Cased in., ft.

Sand

Gas

Oil

Total Depth

PRODUCTION

1st 24 hrs. Nat.

1st 24 hrs. after shot

Gas Cu. Ft.

Dry Hole

Abandoned

Date

AUG 1 1945 19

S. J. LEWIS Scout

