


Section 34 Township 27 Range 6-E
Well No. #2 Schriver (*Shriver*)
Company Cromwell & Lewis

NORTH Miscellaneous

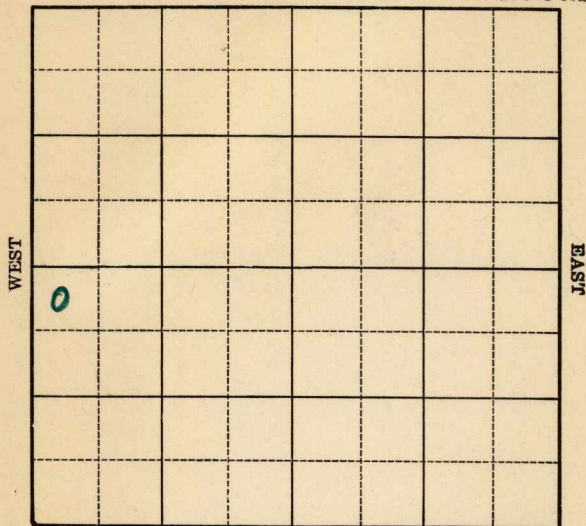

SOUTH

KANSAS

Butler

Sec. 34 Twp. 27 R. 6-EWell No. #2 Schriver FarmCromwell & Lewis Company

(Misc.)


330 Ft. from N. Line

Ft. from S. Line

Ft. from E. Line

330 Ft. from W. Line

Elev. 1404

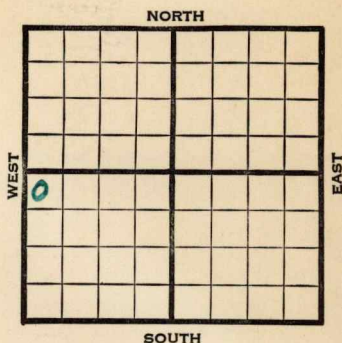

1940

REPORT

12/4 Cellar.

12/12 Drlg. 260'

12/19 12" - 1023' Drlg. 1328'

12/26 Drlg. 1791'

1941

1/2 10" - 1850' 8" - 2320'

Drlg. 2570'

1/9 Miss. 2742' Drlg. 2900'

1/16 Viola 3085' 5" - 3077'

T.D. 3089½' WOC.

1/22 Viola 3085'

5" - 3077'

T.D. 3096'

1000 acid.

Pump 35 bbls.

36. Gravity

COMPLETED

Map No. 11 Sec. 34 Twp. 27 R. 6EWell No. 2 SchriverCromwell & Lewis Company

Contractor

FIRST REPORT

NW SW

330 Ft. from N. Line Ft. from S. Line Ft. from E. Line330 Ft. from W. Line

MISCELLANEOUS

SECTION PLAT

0			

Location Rig up Drilling and Remarks:
Cellar

RECORD

Cased in., ft.Sand Gas Oil Total Depth

PRODUCTION

1st 24 hrs. Nat. 1st 24 hrs. after shot Gas Cu. Ft.Dry Hole Abandoned

Date

DEC 4 1940 19S. J. LEWIS Scout

Map No. 11 Sec. 34 Twp. 27 R. 6EWell No. 2 SchriverCromwell & Lewis Company

Contractor

COMPLETED

NW SW

330 Ft. from N. Line Ft. from S. Line Ft. from E. Line330 Ft. from W. Line**MISCELLANEOUS****SECTION PLAT**

0			

Location Rig up

Drilling and Remarks:

*Viola 3085**5" @ 3077**1000 cu oil**Pump 35 yk.**36" Gr.***RECORD**Cased in., ft.Sand Gas Oil Total Depth 3096.**PRODUCTION**1st 24 hrs. Nat. 1st 24 hrs. after shot Gas Cu. Ft.Dry Hole Abandoned

Date

JAN 22 1941 19S. J. LEWIS Scout