


Cowley

KANSAS
3E

SECTION 30 TOWNSHIP 31S RANGE 3E

WELL NO. #1 Wise

COMPANY M. & F. Oil Co.

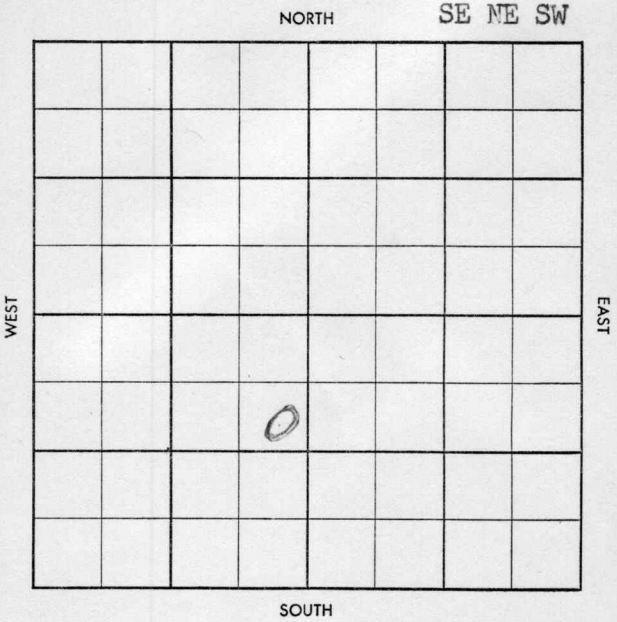

WILDCAT

FORM 513 SUNRAY

29

County Cowley Elev. _____
 Sec. 30 Twp. 31S Rge. 3E
 Company M. & F. Oil Co.
 Farm Name Wise No. 1

Co.

Lse.

No.

Sec.

T.

R.

TOPS	DEPTH	LOG	DATUM
Anh.			
T.P.			
H.			
Tr.			
Dg.			
B.L.			
L.			
K.C.			
B.K.C.			
Ce.			
C.			
M.			
M.			
K.			
Mz.			
Mq.			
V.			
S.			
S.			
A			
R.			
Pe.			
G.			
T.D.			

Loc. in Sec. _____

SE NE SW

Geol. _____

Contr _____

Ark Valley

Tools

Pool

Wildcat

FIRST REPORT

SEP 11 1957

Date Comm. 9-5-57

8" @ 153 - Tite Hole

County Cowley Elev. 1162
 Sec. 30 Twp. 31S Rge. 3E
 Company M. & F. Oil Co.
 Farm Name Wise No. 1

TOPS	DEPTH	LOG	DATUM	Loc. in Sec.														
Anh.				SE NE SW														
TP.																		
H.																		
Tr.																		
Dg.																		
Bl.				Geol. _____ Contr. _____ Ark Valley Tools Pool Wildcat														
L.																		
K.C.																		
B.K.C.																		
Ce.																		
C.																		
M.																		
M.																		
K.																		
Mz.																		
Ma.				<table border="1"> <tr> <td colspan="2">ABANDONED</td> </tr> <tr> <td></td> <td></td> </tr> <tr> <td></td> <td></td> </tr> <tr> <td></td> <td></td> </tr> <tr> <td></td> <td></td> </tr> <tr> <td></td> <td></td> </tr> <tr> <td></td> <td></td> </tr> </table>	ABANDONED													
ABANDONED																		
V.																		
S.																		
S.																		
A.																		
R.																		
PE.																		
G.																		
TD.	<u>3187</u>			OCT 23 '57														

Date Comm. 9-5-57
8" @ 153 - Tite Hole SEP 25 '57 50 1700
 OCT 2 '57 OCT 15 '57 OCT 9 '57 OCT 23 '57

(DBA) (Tite)