

Cowley

Map No. KS Sec. 30 Twp. 31 R. 5-E


Well No. 2 - Coffey Farm
Roth & Gaurat Company

330 Ft. from N. Line

_____ Ft. from S. Line

_____ Ft. from E. Line

990 Ft. from W. Line

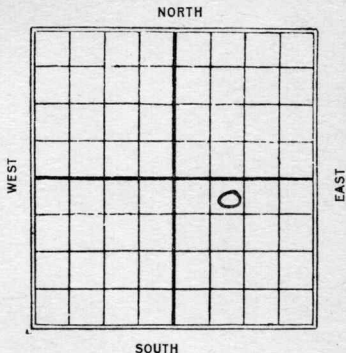

1927

Date

REPORT

Date	REPORT
<u>1/6</u>	<u>Drly 1500' for gas</u>
<u>1/13</u>	<u>Gas 1660-63' - H.F.W. 1690-96</u> <u>shut down</u>
<u>1/19</u>	<u>Gas sand 1660-63</u> <u>T.D. 1696 H.F.W. 1690-96</u> <u>S. & A. 1696</u>

Cowley

Map No. 2 KANSAS Sec. 30 Twp. 31 R. 5 ^E

Well No. 2 *Coffee*
Both & Laurat Company

Contractor

FIRST REPORTS

SECTION PLAT

330 Ft. from N. Line
Ft. from S. Line
Ft. from E. Line
990 Ft. from W. Line

		o	

Location _____
Rig up _____
Drilling and Remarks:
Drily 1500
for gas.

RECORD

Cased _____ in., _____ ft.
Sand _____
Gas _____
Oil _____
Total Depth _____

PRODUCTION

1st 24 hrs. Nat. _____
1st 24 hrs. after shot _____
Gas _____ Cu. Ft.
Dry Hole _____
Abandoned _____

Date JAN 6 1927

CHAS. L. SHERWOOD

Cowley

2 KANSAS Map No. Sec. 30 Twp. 31 R. 5

Well No. 2 Cofsey Loth & Faurot Company

Contractor

COMPLETED

SECTION PLAT

330 Ft. from N. Line

Ft. from S. Line

Ft. from E. Line

990 Ft. from W. Line

ABANDONED

		o	

Location

Rig up

Drilling and Remarks:

S&S 1660-63

AFW 1690-96

DRG 1696

RECORD

Cased in., ft.

Sand

Gas

Oil

Total Depth 1696

PRODUCTION

1st 24 hrs. Nat.

1st 24 hrs. after shot

Gas Cu. Ft.

Dry Hole

Abandoned

Date

JAN 19 1927

CHAS. L. SHERWOOD

192 Scout