


Map No. _____ Sec. 18 Twp. 20 R. 9
 Well No. 1 Proffitt Farm _____
Mid-Kansas Company _____

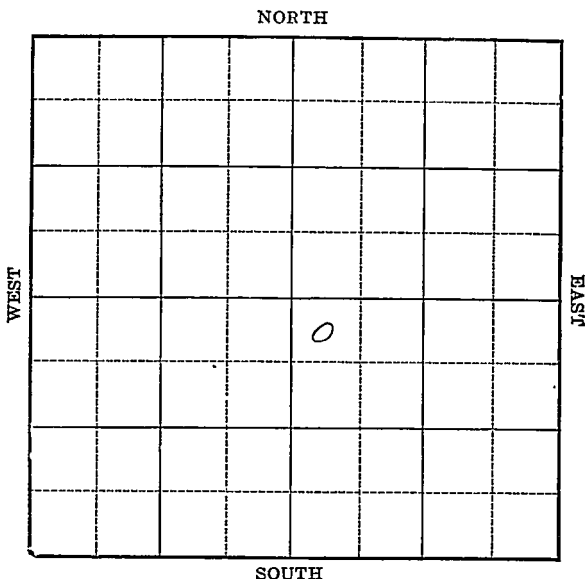

Location _____
 Drilling Remarks _____

Rig Up _____
 Drilling Remarks _____

RECORD

Cased _____ in. _____ ft.
 Sand _____
 Gas _____
 Oil _____
 Total Depth _____

PRODUCTION

1st 24 hrs. Nat. _____
 1st 24 hrs. after shot _____
 Gas _____ cu. ft.
 Dry Hole _____
 Abandoned _____

Rice

Map No. KANSAS Sec. 18 Twp. 20 R. 9^W


Well No. 1 Proffitt Farm
Mid-Kansas Company

330' Ft. from N. Line

_____ Ft. from S. Line

_____ Ft. from E. Line

330' Ft. from W. Line

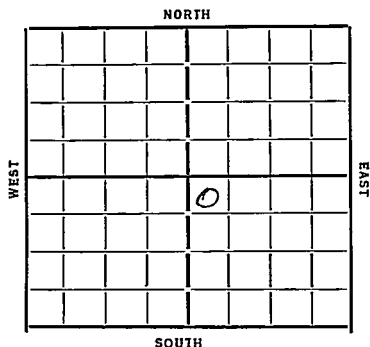

Date 1/9/33

REPORT

12/6 Moving in
12/13 Rig
12/27 Rigging
1/4 15" at 390
1/11 Drlg 1585
1/17 " 1985 12" at 1730
1/24 Fishing at 2005
1/31 Drlg 2085
2/7 2242-74 5 M Hw 50
2/14 10" 2092 8" 2230 NR 8" 2555
2/23 TD 2555 N.R. 8" 2385
3/1 Drlg 2585
3/8 " 2915 8" 2615
3/15 " 3222 show oil 3105-10
3/22 Sil. line 3327 Oil 3326-29
75 3331 5" 3327 2500' oil
4/4 Siliceous 3327 TD 3331
1301 Bbls.

COMPLETED

Map No. 49 Sec. 18 Twp. 20 R. 9WWell No. 1-ProffittMid-Kansas Company

Contractor

FIRST REPORTS

330 Ft. from N. Line

Ft. from S. Line

Ft. from E. Line

330 Ft. from W. Line

SECTION PLAT

		0	

Location

Rig up

Drilling and Remarks:

Moving in

RECORD

Cased _____ in., _____ ft.

Sand _____

Gas _____

Oil _____

Total Depth _____

PRODUCTION

1st 24 hrs. Nat. _____

1st 24 hrs. after shot _____

Gas _____ Cu. Ft.

Dry Hole _____

Abandoned _____

Date

12-6-33 192 O. Mannescheck Secut

Map No. 49 Sec. 18 Twp. 20 R. 9WWell No. 1 - ProffittMid - Kansas Company

Contractor

COMPLETED

SECTION PLAT

		0	

330 Ft. from N. Line

Ft. from S. Line

Ft. from E. Line

330 Ft. from W. Line

Location

Rig up

Drilling and Remarks:

1301 bbls

RECORD

Cased in., ft.

~~Sand~~ silicious 3327

Gas

Oil

Total Depth 3331

PRODUCTION

1st 24 hrs. Nat.

1st 24 hrs. after shot

Gas Cu. F

Dry-Hole

Abandoned

Date

4-4-34 192O. Mannes