


Section 22 Township 20 Range 12W

Well No. 1 Miller

Company Heathman-Seeligson

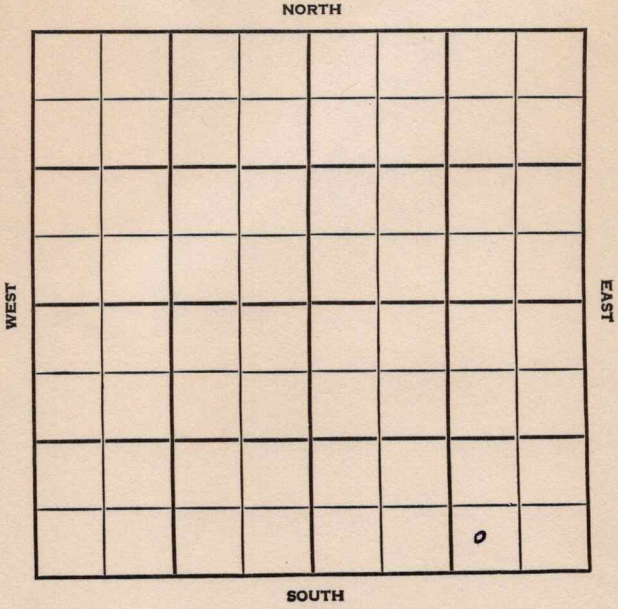

Barton

KANSAS


SEC.	TWP.	R.
22	20	12W ✓

WELL NO. #1 Miller FARM

COMPANY Heathman-Seeligson

CONTRACTOR Co. Tools.

\_\_\_\_\_ Ft. from N. Line  
 330 \_\_\_\_\_ Ft. from S. Line  
 990 \_\_\_\_\_ Ft. from E. Line  
 \_\_\_\_\_ Ft. from W. Line

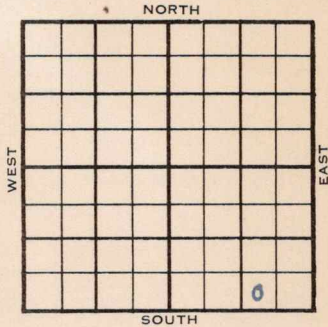

SW SE SE

1954	ELEVATION	REPORT
	1837'	

5/26  
6/2

Location  
 8" @ 260' w/225 sks  
 Anhy 627', Heeb 3023', Br li 3148',  
 L ans 3164'

6/9

Drlg.  
 Spud 5-25-54  
 D&A  
 TD 3460'  
 8" @ 260'  
 Anhy 627', Heeb 3023', Br lime 3148',  
 L ans 3164'  
 DST 3179-3202', opn 1 hr., rec. 15'  
 mud, O#  
 DST 3288-3312', opn 1 hr., rec. 5' mud,  
 O#  
 Cong 3392', Arb. 3439'  
 TD 3460'  
 D&A

ABANDONED



