


Section 22 Township 20 Range 12 WWell No. # 1 SteckleCompany Alpine Oil & Royalty

NORTH

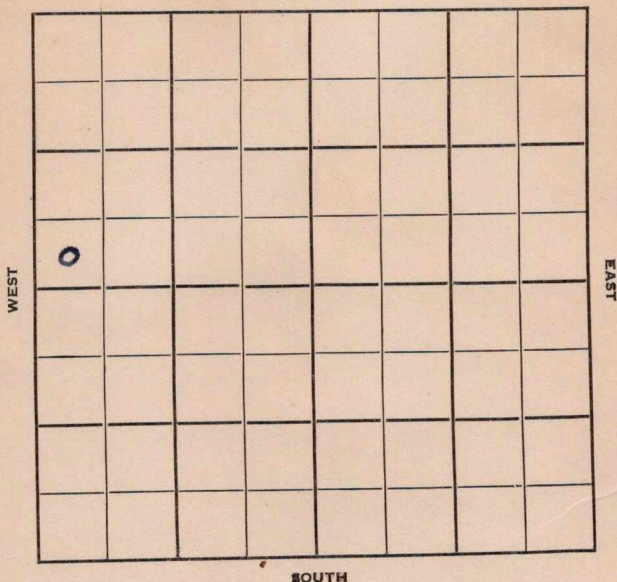

Barton

KANSAS

Sec. 22 Twp. 20 R. 12W

Well No. #1 Steckle Farm

Alpine Oil & Royalty Company

Quakrer Contractor


Ft. from N. Line

330 Ft. from S. Line

Ft. from E. Line

330 Ft. from W. Line

SW SW NW

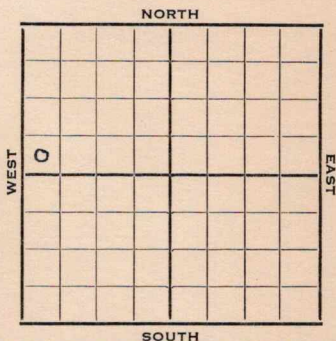

1952

Elev. 1828'

REPORT

4/30

Spud 4-26-52

? 255'

Drlg. 2040'

5/7

Heeb 3018' Br li 3141' Lans. 3157'

DST 3172-3234' 1 hr, 25' M Off

DST 3278-3300' 1/2 hr, 5' M Off

Drlg. 3350'

5/13

Spud 4-26-52

D&A TD 3430' 8" @ 255'

Heeb. 3018

Br Li 3141

Lans. 3157

DST 3172-3234 open 1 hr. rec. 25' mud

DST 3278-3300 open 1/2 hr. Rec. 5' mud

Cong. 3387 TD 3430'

D&A

ABANDONED

County Barton State KansasSec. 22 (Blk.) 20 (Sur.) 12W Map No.Operator Alpine Oil & RoyaltyWell No. 1 Farm SteckleElev. Location SW SW NW

FIRST REPORT

330 Ft. From S Line NW330 Ft. From W Line Quarter1st. Report APR 30 1952

Completion

Remarks

Quaker - Contr.Spudding Date 4-26-52

Drlg. Data

3" @ 255 Drlg. 2040

J. G. McGEHEE

County Barton State Kansas
 Sec. 22 (Blk. Twp.) 20 (Sur. Rge.) 12W Map No.
 Operator Alpine Oil & Royalty
 Well No. 1 Farm Steckle
 Elev. 1828 Location SW SW NW



330 Ft. From S Line NW

330 Ft. From W Line Quarter

Ist. Report

Completion MAY 14 1952

Remarks

Quaker Drlg. - Contr.

Spudding Date 4-26-52

Drlg. Data D & A TD 3430

8" @ 255 Heeb. 3018 Br. lime 3141

Lans. 3157 DST 3172-3234 open 1 hr.

Rec. 25' mud DST 3278-3300 open $\frac{1}{2}$ hr.

Rec. 5' mud Cong. 3387 TD 3430

D & A

J. G. McGEHEE