
FORM 51 25M 3-49 PETROL KANSAS Barton

Section 22 Township 20 Range 12W

Well No. #1 Steckel "A"

Company W.J. Coppinger & Bay Petr.

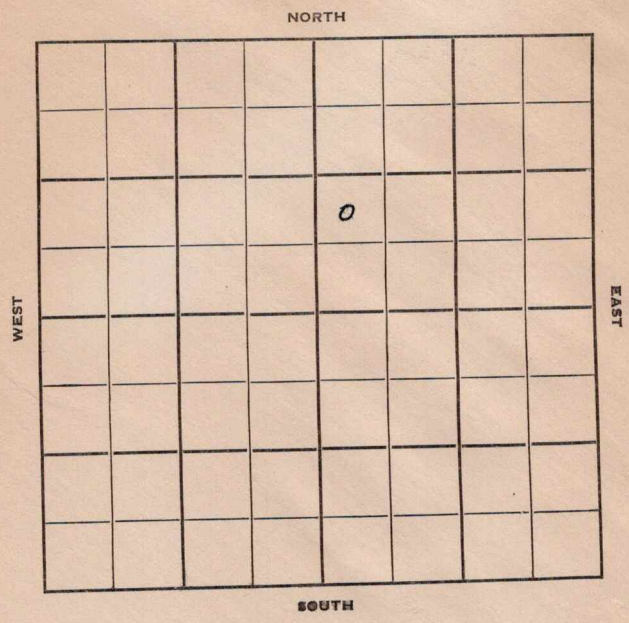

FORM 252-B
10M 9-49 PETROL

KANSAS

Barton

Sec. 22 Twp. 20 R. 12-W

Well No. #1 Steckel "A" Farm

W. J. Coppinger & Bay Petroleum Company

Contractor

Bryant


____ Ft. from N. Line

990 Ft. from S. Line

____ Ft. from E. Line

330 Ft. from W. Line

NW SW NE

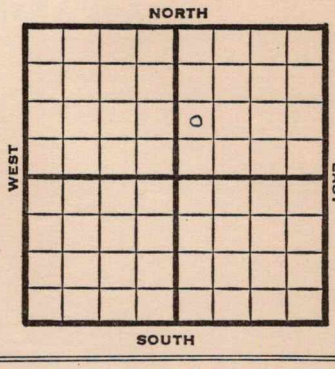

1950	Elev 1825 REPORT
9/13	Spud 9-2-50 8 5/8" @ 290 Anhy 615 Drlg 2715
9/20	8 5/8" @ 290 Anhy 615 Br lime 3128 Lans 3154 DST 3182-3202 rec mud Arb 3382 DST 3397-3406 opn 45 min rec 20' mud DST 3408-38 opn 45 min rec 22' mud TD 3448 D&A ABANDONED

FORM 275 FOR SALE BY KANSAS BLUE PRINT CO.


County Barton State Kansas

Sec. 22 (Blk. Twp.) 20 (Sur. Rge.) 12W Map No.

Operator W. J. Coppinger & Bay Petroleum

Well No. 1 Farm Steckel "A"

Elev. 1825 Location NW SW NE

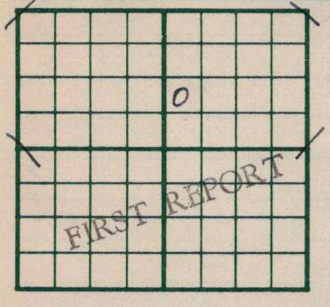

990 Ft. From S Line NE

330 Ft. From W Line Quarter

1st. Report SEP 13 1950

Completion

Remarks

Spudding Date 9-2-50

Drlg. Data Bryant Pool

8 5/8" @ 290 Anhy 615 drlg. 2715

J. E. TYRA

FORM 275 FOR SALE BY KANSAS BLUE PRINT CO.


County Barton State Kansas

Sec. 22 (Blk. Twp.) 20 (Sur. Rge.) 12W Map No.

Operator W.J. Coppinger & Bay Petroleum

Well No. 1 Farm Steckel "A"

Elev. 1825 Location NW SW NE

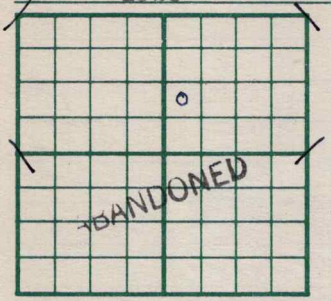

990 Ft. From S Line NE

330 Ft. From W Line Quarter

1st. Report SEP 20 1950

Completion SEP 20 1950

Remarks

Bryant Pool

Spudding Date 9-2-50

Drlg. Data D & A TD 3448

8 5/8" @ 290 Anhy 615 Br. lime 3128

Lans. 3154 DST 3182-3202 Rec. mud

Arb. 3392 DST 3397-3406 open 45 min.

Rec. 20' mud DST 3408-38 open 45 min.

Rec. 22' mud TD 3448 D & A

J. E. TYRA