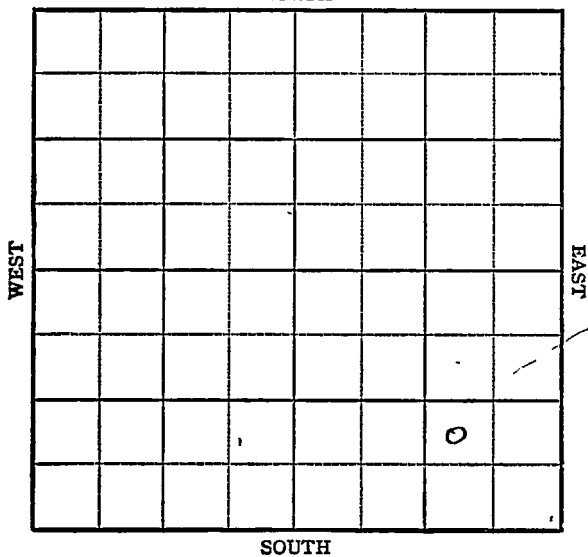


KANSAS

Section 18 Township 20 Range ~~10~~ 9Well No. 2 ProffittCompany J.C. DozierChase Pool
NORTH

KANSAS

Rice

W
~~LOW~~

Sec. 18 Twp. 20 R.

Well No. #2 Proffitt Farm

J. C. Dozier Company

Chase Pool


Ft. from N. Line

990' Ft. from S. Line

990' Ft. from E. Line

Ft. from W. Line

NW SE SE

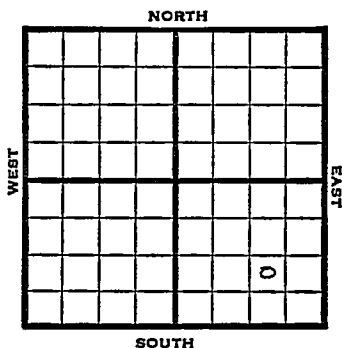

1948

Eli 1787'

R E P O R T

10/20

8" @ 184'
Anhy. 400'
Drlg. 2392'

10/26

Simpson 3314'
TD 3318'
5" @ 3315'

11/10

Pump 20 bbls oil a day

11/16

"

11/23

"

12/1

TD 332 6'
Simpson 3314'
5"@ 3315'
Pump 25 Oil Pot
42⁸ Gr.
Comp

COMPLETED

Map No. 49 Sec. 18 Twp. 20 R. 9W

Well No. 2 Proffitt

J. C. Dozier Company

CORRECTION Contractor

NW SE SE

SECTION PLAT

 Ft. from N. Line

990 Ft. from S. Line

990 Ft. from E. Line

 Ft. from W. Line

Rice County

Location

Rig up

Drilling and Remarks:

Reported
10-20-10W

RECORD

Cased in., ft.

Sand

Gas

Oil

Total Depth

PRODUCTION

1st 24 hrs. Nat.

1st 24 hrs. after shot

Gas Cu. Ft.

Dry Hole

Abandoned

Date

OCT 27 1948

19

S. J. LEWIS

Scout

Map No. _____ Sec. 18 Twp. 20 R. 10W

Well No. 2 Proffitt

J. C. Dozier Company

FIRST REPORT Contractor

NW SE SE

SECTION PLAT

			6

_____ Ft. from N. Line

990 Ft. from S. Line

990 Ft. from E. Line

_____ Ft. from W. Line

Rice County

Location _____

Rig up _____

Drilling and Remarks:

8" @ 184

Anhy 400

drlg. 2392

RECORD

Cased _____ in., _____ ft.

Sand _____

Gas _____

Oil _____

Total Depth _____

PRODUCTION

1st 24 hrs. Nat. _____

1st 24 hrs. after shot _____

Gas _____ Cu. Ft.

Dry Hole _____

Abandoned _____

Date

OCT 20 1948 19 S. J. LEWIS Scout

Kansas

Map No. 49 Sec. 18 Twp. 20 R. 9WWell No. 2 ProffittJ. C. Dozier

Company

COMPLETE

Contractor

NW SE SE

E. 11787
SECTION PLAT

			0

Ft. from N. Line990 Ft. from S. Line990 Ft. from E. LineFt. from W. Line

Rice County

Location

Rig up

Drilling and Remarks:

Drill 33145' C 3315Run 25 oil 1st42 5' 5"

RECORD

Cased _____ in., _____ ft.

Sand _____

Gas _____

Oil ☒Total Depth 2326

PRODUCTION

1st 24 hrs. Nat. _____

1st 24 hrs. after shot _____

Gas _____ Cu. Ft.

Dry Hole _____

Abandoned _____

Date

DEC 1 1948

19

S. J. LEWIS Scout