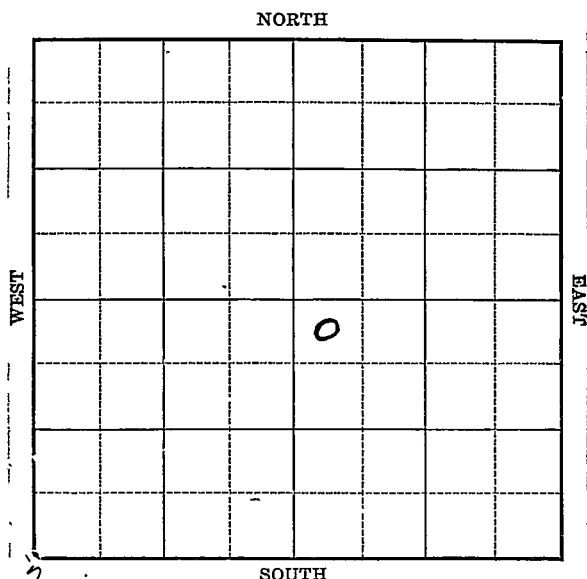


Rice

Map No. **KANSAS** Sec. *18* Twp. *20* R. *9W*
 Well No. *7 Proffitt* Farm
Mid - Kansas Company

*Trwin #1.*

Location _____

Drilling Remarks _____

Rig Up _____

Drilling Remarks _____

RECORD

Cased _____ in. _____ ft.

Sand _____

Gas _____

Oil _____

Total Depth _____

PRODUCTION

1st 24 hrs. Nat. _____

1st 24 hrs. after shot _____

Gas _____ cu. ft.

Dry Hole _____


Abandoned _____

Rice

Map No. **KANSAS** Sec. 18 Twp. 20 R. 9WWell No. 2 Proffitt Farm
Mid - Kansas Company270 Ft. from N. Line

_____ Ft. from S. Line

_____ Ft. from E. Line

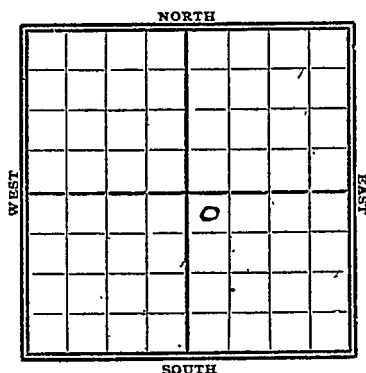320 Ft. from W. Line

Twin #1.

Date
1924

REPORT

4/11 Location
 4/19 Bldg Rig
 4/26 Rly 610 15" 104 12" 563
 5/3 " 1825
 5/9 T.D 2288 2 3/4 m Gas.

COMPLETED

KANSAS

Map No. 49 Sec. 18 Twp. 20 R. 9WWell No. 2-ProffittMid-Kansas Company

Contractor

FIRST REPORT

270 Ft. from N. Line

Ft. from S. Line

Ft. from E. Line

320 Ft. from W. Line

SECTION PLAT

		0	

Twin #1Location ✓

Rig up

Drilling and Remarks:

RECORD

Cased in., ft.

Sand

Gas

Oil

Total Depth

PRODUCTION

1st 24 hrs. Nat.

1st 24 hrs. after shot

Gas Cu. Ft.

Dry Hole

Abandoned

Date

4-11-34 C. Mannick 192 Scout

Map No. 49 Sec. 18 Twp. 20 R. 9W

Well No. 2-proppitt

Mich-Kansas Company

Contractor

SECTION PLAT

		0	

270 Ft. from N. Line

_____ Ft. from S. Line

_____ Ft. from E. Line

320 Ft. from W. Line

Location _____

Rig up _____

Drilling and Remarks:

RECORD

Cased _____ in., _____ ft.

Sand _____

Gas _____

Oil _____

Total Depth 2288

PRODUCTION

1st 24 hrs. Nat. _____

1st 24 hrs. after shot _____

Gas _____ Cu. Ft.

Dry Hole _____

Abandoned _____

Date

5-9-37 19 ORVAL MANNSCHRECK Scout

23 1/4 mil gas