


Rice

Map No. KANSAS Sec. 18 Twp. 20 R. 90

Well No. 2 Maremore Farm _____

Webb Company

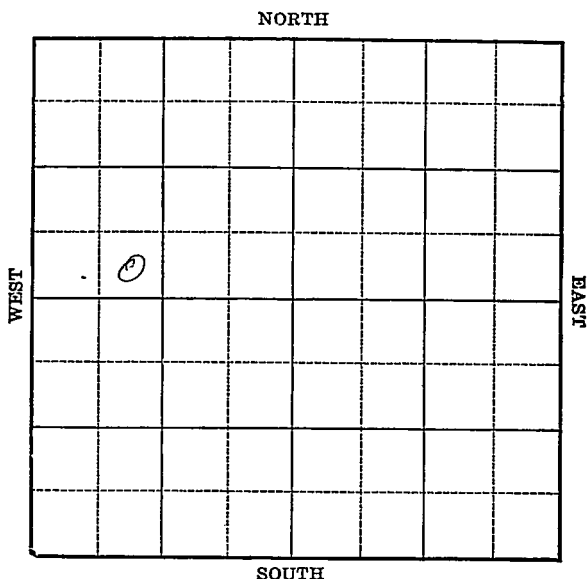

Location _____

Drilling Remarks _____

Rig Up _____

Drilling Remarks _____

RECORD

Cased _____ in. _____ ft.

Sand _____

Gas _____

Oil _____

Total Depth _____

PRODUCTION

1st 24 hrs. Nat. _____

1st 24 hrs. after shot _____

Gas _____ cu. ft.

Dry Hole _____

Abandoned _____

Well No. 2 Masemore Farm


Wesbrook Oil Company

730' Ft. from S. Line

Ft. from E. Line

990' Ft. from W. Line

NORTH

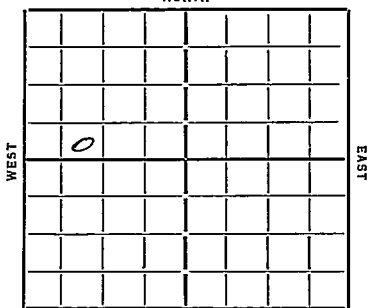

SOUTH

Date 1933

REPORT

11/15	Location
-------	----------

11/22 — 11/29 — 12/6 —

12/12 — 12/27 — 1/11 —

1/17 | Avg 260

1/24	"	1430
------	---	------

1/31	"	1900
------	---	------

2/7 NR 10" 2430

2/14 10" 2459 Fishy 2486

2/23 Arly 2610 10" 2573

2/1	" 3100	K C. L. 3000
-----	--------	--------------

3/8	Sil Lime 3322 Simp 3309
-----	-------------------------

75 3328 2500' oil

3/14 Siliceous 3322 75 3328

Pot 1684 BBlu.

COMPLETED

Map No. 49 Sec. 18 Twp. 20 R. 9W

Well No. 2-Masemore

Werkrose Oil Company

Contractor

SECTION PLAT

0			

Ft. from N. Line

330 Ft. from S. Line

Ft. from E. Line

990 Ft. from W. Line

FIRST REPORTS

Location ☒

Rig up

Drilling and Remarks:

RECORD

Cased in., ft.

Sand

Gas

Oil

Total Depth

PRODUCTION

1st 24 hrs. Nat.

1st 24 hrs. after shot

Gas Cu. Ft.

Dry Hole

Abandoned

Date

11-15-33 192

O. Manscheck Scout

Map No. 49 Sec. 18 Twp. 20 R. 9WWell No. 2-Masernore
Werbrose Oil Company

Contractor

COMPLETED

SECTION PLAT

0			

Ft. from N. Line

330 Ft. from S. Line

Ft. from E. Line

990 Ft. from W. Line

Location.....

Rig up.....

Drilling and Remarks:

RECORD

Cased.....in.,ft.

Sand silicious 3322

Gas.....

Oil.....

Total Depth 3328

PRODUCTION

1st 24 hrs. Nat.....

1st 24 hrs. after shot.....

Gas.....Cu. Ft.

Dry Hole.....

Abandoned.....

Date

3-14-34 C. J. Marnick
192 Scot