

Map No. KANSAS Sec. 18 Twp. 20 R. 9
Well No. 3 Heibel Farm
Empire Company

Well No. 3 Heibel Farm

Empire Company

NORTH

WEST

FAST

SOUTH

Location

Drilling Remarks

Rig Up

Drilling Remarks

RECORD

Cased_____in. _____ft.

Sand_____

Gas

Oil

Total Depth_____

PRODUCTION

1st 24 hrs. Nat.-----

1st 24 hrs. after shot-----

Gas _____cu. ft._____

Dry Hole

Abandoned_____

Rice

Map No. KANSAS Sec. 18 Twp. 20 R. 9W

Well No. 3 Hebble Farm


Empire Company

330' Ft. from N. Line

_____ Ft. from S. Line

_____ Ft. from E. Line

1155 Ft. from W. Line

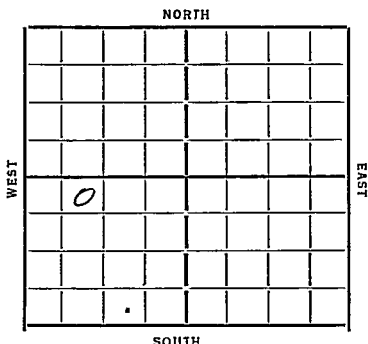

Date 1933

REPORT

12/13 L.O.

12/27 R.O.Y.

1/11 Rig

1/17 — 1/24 — 1/31 —

2/17 Rigging Up

2/14 Drg 310

2/23 " 1115 15 1/2" 384

3/1 " 1850 12" 1215

3/8 " 2365

3/15 " 2580 10" at 1885

2474 2425-30 8" at 2540

3/22 Drg 2895

3/29 " 3195

4/5 6" 3304 Siliceous 3311

P.B.P.

4/18 Siliceous 3311 TD 3326

1283 Bkls 22 hrs.

COMPLETED

Map No. 49 Sec. 18 Twp. 20 R. 9W

Well No. 3-Heckel

Empire Company

Contractor

FIRST REPORTS

330 Ft. from N. Line

..... Ft. from S. Line

..... Ft. from E. Line

1155 Ft. from W. Line

SECTION PLAT

o			

Location.....

Rig up.....

Drilling and Remarks:

RECORD

Cased.....in.,ft.

Sand.....

Gas.....

Oil.....

Total Depth.....

PRODUCTION

1st 24 hrs. Nat.....

1st 24 hrs. after shot.....

Gas.....Cu. Ft.

Dry Hole.....

Abandoned.....

Date

12-13-33 192 C. Mamuchek Scout

KANSAS

Map No. 49 Sec. 18 Twp. 20 R. 9WWell No. 3-HeckelEmpire Oil Company

Contractor

COMPLETED**SECTION PLAT**

0			

330 Ft. from N. Line

_____ Ft. from S. Line

_____ Ft. from E. Line

1155 Ft. from W. Line

Location _____

Rig up _____

Drilling and Remarks:

1283 bbls22 hrs**RECORD**

Cased _____ in., _____ ft.

Sand blue sand 3311

Gas _____

Oil _____

Total Depth 3326**PRODUCTION**

1st 24 hrs. Nat. _____

1st 24 hrs. after shot _____

Gas _____ Cu. Ft.

Dry Hole _____

Abandoned _____

Date

4-18-34 19

CRUEL MANI CHECK

Scout