Form 51—5M—3-26—22544


Sumner

Map No. Kar Sec. 25 Twp. 31 R. 2E

Well No. 1 River Bed #1-B SHORE Farm

Louisiana Nat Co Company

NORTH SHELL PET.

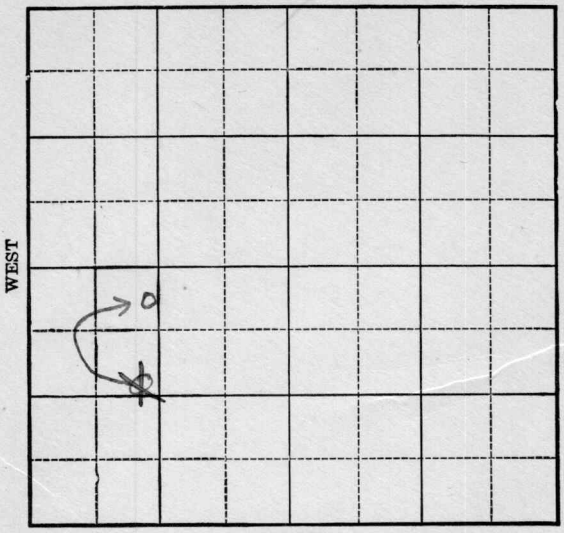

O.W.D.D

Location

Drilling Remarks

Rig Up

Drilling Remarks

RECORD

Cased in. ft.

Sand

Gas

Oil

Total Depth

PRODUCTION

1st 24 hrs. Nat.

1st 24 hrs. after shot

Gas cu. ft.

Dry Hole

Abandoned

Form 252A—5M—11-25—20913 Sumner

Map No. Sec. 25 Twp. 31 R 2E

Well No. #1-B SHORE / River Bed Farm


~~Rotary Pet. Corp~~ Shell Pit Company

330 Ft. from N. Line

~~1540~~ Ft. from S. Line

~~1235~~ Ft. from E. Line

1254 Ft. from W. Line

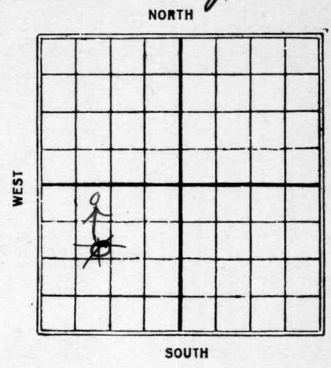

1926

Date	REPORT O.W.D.D
9/22	Location
9/29	same
10/6	N.R. High water
10/13	same
10/20	same
10/27	Same
11/3	Rig Bldg
11/10	same
11/17	Rigging up
11/24	Drlg 250
12/1	" 1070
12/8	1586' to 88' - 100 ft oil Drlg 1594'
12/15	S.D. to build tanks
	T.S. 1825' - T.D. 1841' - filled up 1700' oil 3 hrs
12/21	T.D. 1889 swabbed + flowed 1209 bbls in 24 hrs natural
12/29	Top sand 1825
	T.D. 1889 1209 bbls
	Shot 115 qts
	2000 bbls 24 hrs

OVER

1936

O. W. D. D

1/22 Rig tubg

1/31 Rdg 2150

2/7 TD 2178
Swbbd 148 Oil 6 hrs.

2/14 TICC 2157 7" 2160
TD 2179 3000 acid
pumped 587 Oil 12 hrs.
Taking pot

2/19 IC C 2157
TD 2179
3000 acid
761 Bbls.

COMPLETED

Form 26—1M Bks. 3-23-11959.


Map No. 1 KANSAS Sec. 25 Twp. 21 R. 2E

Well No. 1 River Bed

Roxana Pet. Corp. Company

Contractor

SECTION PLAT

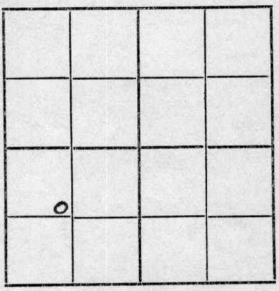

Ft. from N. Line

1540 Ft. from S. Line

1735 Ft. from E. Line

Ft. from W. Line

FIRST REPORTS

Location

Rig up

Drilling and Remarks:

Location

RECORD

Cased in., ft.

Sand

Gas

Oil

Total Depth

PRODUCTION

1st 24 hrs. Nat.

1st 24 hrs. after shot

Gas Cu. Ft.

Dry Hole

Abandoned

Date

SEP 22 1926

192

S. J. LEWIS Scout

Form 20—1M Bks.—3-23—11959.

Sumner.

KANSAS


Map No._____ Sec. 25 Twp. 31 R. 2 E.

Well No. 1 Rivet Bed

Roxana Pet. Corp. Company

_____ Contractor

SECTION PLAT

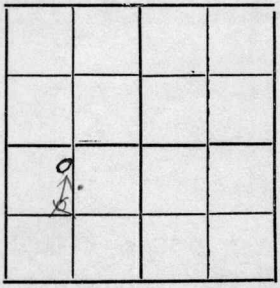

330 Ft. from N. Line

_____ Ft. from S. Line

_____ Ft. from E. Line

1254 Ft. from W. Line

Correction

Location _____

Rig up _____

Drilling and Remarks:

Report this
1540 from S. L.
1735 " E L
should be
330 from N L
1254 from W. L.

RECORD

Cased _____ in., _____ ft.

Sand _____

Gas _____

Oil _____

Total Depth _____

PRODUCTION

1st 24 hrs. Nat. _____

1st 24 hrs. after shot _____

Gas _____ Cu. Ft.

Dry Hole _____

Abandoned _____

Date

DEC 21 1926 192____

S. J. LEWIS Scout

Form 20—1M Blks.—3-23—11959.

Gunter


Map No. KANSAS Sec. 25 Twp. 31 R. 2E

Well No. 1 River Bed

Roxana Pet Corp. Company

Contractor

SECTION PLAT

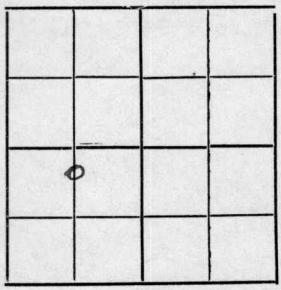

330 Ft. from N. Line

Ft. from S. Line

Ft. from E. Line

1254 Ft. from W. Line

COMPLETED

Location

Rig up

Drilling and Remarks:

T.D. 1825

T.D. 1889

1209 Bbls Na D.

Shot 1159 qts.

2000 Bbls - 24 hrs

Flow 2 swabbed

RECORD

Cased in., ft.

Sand

Gas

Oil

Total Depth

PRODUCTION

1st 24 hrs. Nat.

1st 24 hrs. after shot

Gas Cu. Ft.

Dry Hole

Abandoned

Date

DEC 29 1926

192

S. J. LEWIS Scout

Summer
Form 26—1M Bks.—9-26

KANSAS


Map No. 1 Sec. 25 Twp. 31 R. 2 E

Well No. 1 - "B" Shore

Shell Pet Company

Contractor

SECTION PLAT

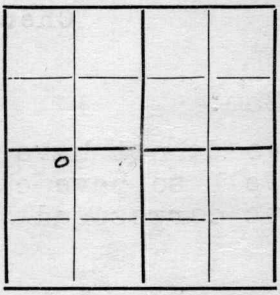

330 Ft. from N. Line

Ft. from S. Line

Ft. from E. Line

~~990~~ 1254 Ft. from W. Line

FIRST REPORT

OWDD

Location

Rig up

Drilling and Remarks:

OTD 1899

fsg tubing

CORRECTION

COMPANY NAME

FARM NAME

WELL #

RECORD

Cased in., ft.

Sand

Gas

Oil

Total Depth

PRODUCTION

1st 24 hrs. Nat.

1st 24 hrs. after shot

Gas Cu. Ft.

Dry Hole

Abandoned

Date

JAN 22 1936

192 Scout

ORVAL M. MINSCHECK

Our feet measurements
on your first report show
this well XX
330 ft. N. Line
1254 Ft. W. Line
Check advise
Sam

Sam:

We do not have record of this old well so have changed our tickets to correspond with yours.

Hatfield

Pool no record

Pool

Returned
Cards
Tracing
France Map
Scarborough Map
Moody Map
Scarborough Plat Book
Moody Plat Book

Form 26—1M Blks., 9-28

KANSAS

Sumner

Map No. ..... Sec. 25 Twp. 31 R. 2 E


Well No. 1 – Shore 'B'

Shell pet ..... Company

..... Contractor

COMPLETE

SECTION PLAT

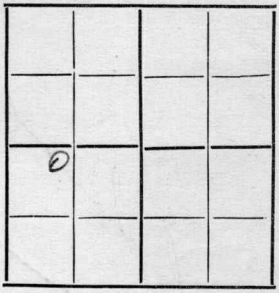

330 Ft. from N. Line

..... Ft. from S. Line

..... Ft. from E. Line

1274 Ft. from W. Line

Ow DD

Location .....

Rig up .....

Drilling and Remarks:

3000 and

761 bbls

RECORD

Cased ..... in., ... ft.

~~Sand~~ S.C. 2157

Gas .....

Oil .....

Total Depth 2179

PRODUCTION

1st 24 hrs. Nat. .....

1st 24 hrs. after shot .....

Gas ..... Cu. Ft.

Dry Hole .....

Abandoned .....

Date

2-19-36 192....

ORVAL MANNSCHRECK ..... Scout