


Section 23 Township 20 Range 12W

Well No. 2 ~~#1~~ Johnson

Company Lewis Drlg. Company

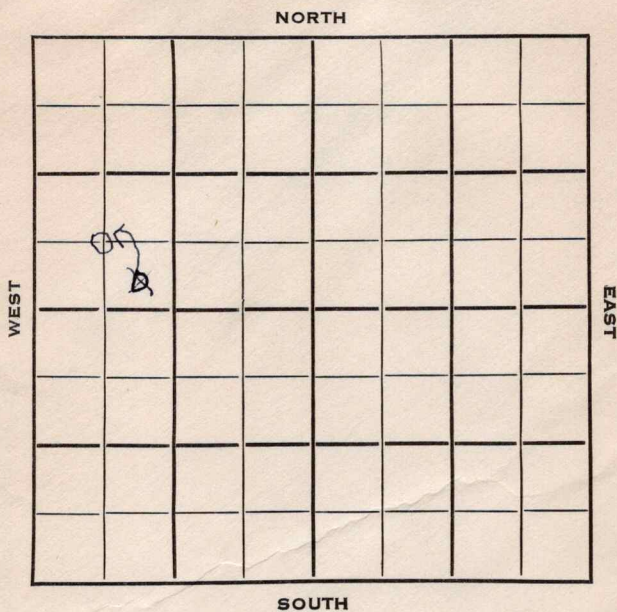

O.W.W.O. Barton

KANSAS

Sec. 23 Twp. 20 R. 12W

Well No. #2 Johnson Farm

Lewis Drlg. Company

Lewis Drlg. - Contr. Contractor
Chase-Silica Pool


Ft. from N. Line

660
330 Ft. from S. Line

Ft. from E. Line

660
990 Ft. from W. Line

C
SE SW NW

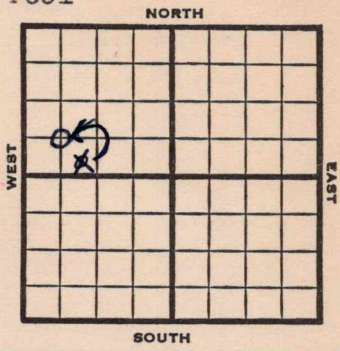

1953 Elev. 1815' REPORT

3/4 Spudded 3/3/52
3/12 8" @ 173
Drlg. 1970
3/18 Spud 3-3-53
D&A
TD 3400
8" @ 173
Heeb 3004, Br lime 3130, Lans 3145
DST 3153-84, opn 1/2 hrs., rec.
10' mud, 0#
Arb. 3392
TD 3400
D&A

ABANDONED

O.W.W.O.

1953
10/28 KC 3145' Arb. 3392' TD 3400
DD 3405' 5" @ 3400

12/16 No report

1954
1/13 Oil well TD 3405' Lans. 3130'
Cong. 3366' Arb. 3373' TD 3405'
CO to 3399' 81/3382-90 1000 A
S/10 1/2 GO 1 1/2 GW PB 3378
60/3372-78 1000 A S/21 GO

OVER

1954
1/13

743174

(Information continued)

CO to 3399 Frac. $1\frac{1}{4}$ BOPH 8 hr.

S/1 BOPH

Comp. 10 BOPD

COMPLETED

County Barton State Kansas
Sec. 23 (Blk.) 20 (Sur.) 12W Map No.
Operator Lewis Drlg.
Well No. 1 Farm Johnson
Elev. _____ Location SE SW NW


0

FIRST REPORT

330 Ft. From S Line NW
990 Ft. From W Line Quarter
1st. Report MAR 4 1953
Completion _____
Remarks Lewis Drlg. - Contr.
Spudding Date 3-3-52

Drlg. Data

County Barton State Kansas
 Sec. 23 (Blk. Twp.) 20 (Sur. Rge.) 12W Map No. _____
 Operator Lewis Drlg.
 Well No. 1 Farm Johnson
 Elev. 1815 Location SE SW NW

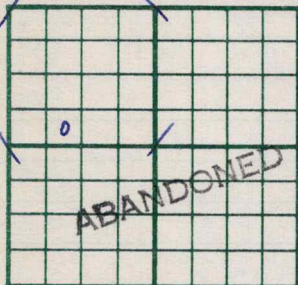

330 Ft. From S Line NW
 990 Ft. From W Line Quarter

1st. Report _____

Completion MAR 1 9 1953

Remarks _____

Lewis Drlg. - Contr.

Spudding Date 3-3-52

Drlg. Data D & A TD 3400

8" @ 173 Heeb. 3004 Br. lime 3130

Lans. 3145 DST 3153-84 open $\frac{1}{2}$ hr.

Rec. 10' mud 0# Arb. 3392 TD 3400

D & A

J. G. McGEHEE

Kansas

Map No. _____ Sec. 23 Twp. 20 R. 12WWell No. 2 Johnson (was #1 Johnson)Lewis Drlg. (was J.H.Hershey) CompanyCORRECTION Contractor

C SW NW

SECTION PLAT

_____ Ft. from N. Line

_____ 660 Ft. from S. Line

_____ Ft. from E. Line

_____ 660 Ft. from W. Line

Barton County

Location _____

Rig up _____

Drilling and Remarks:

Reported

#1 Johnson

RECORD

Cased _____ in., _____ ft.

Sand _____

Gas _____

Oil _____

Total Depth _____

PRODUCTION

1st 24 hrs. Nat. _____

1st 24 hrs. after shot _____

Gas _____ Cu. Ft.

Dry Hole _____

Abandoned _____

Date

JAN 13 1954

19

J. G. McGEHEE

Scout

O.W.W.O.

County Barton State Kansas
 Sec. 23 (Blk.) 20 (Sur.) 12W Map No.
 Operator Lewis D. lg. (was J. H. Hershey)
 Well No. 2 Farm Johnson (was #1 Johnson)
 Elev. 1815 Location C SW NW

660 Ft. From S Line NW660 Ft. From W Line Quarter

1st. Report

JAN 13 1954

Completion

Remarks

OWWO

Spudding Date

O.W.W.O.

Drlg. Data Oil well TD 3405
Lans. 3130 Cong. 3366 Arb. 3373
TD 3405 CO to 3399 81/ 3382-90
1000 A S/ 10½ go 1½ gw PB 3378
60/ 3372-78 1000 A S/ 21 go CO to 3399
frac 1¼ boph 8 hr. S/ 1 boph
Comp. 10 bopd

J. G. McGEHEE