

Butler


KANSAS

SECTION 12 TOWNSHIP 27 RANGE 7E

WELL NO. #1 Worrell

COMPANY White & Ellis

NORTH

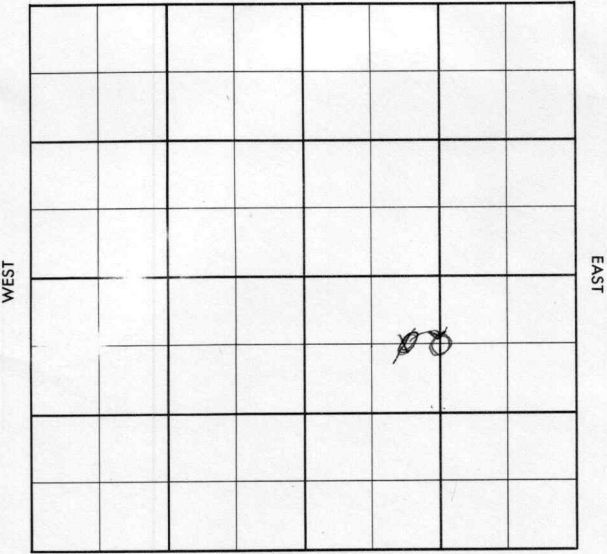

SOUTH

Butler

KANSAS

SEC.

TWP.

R.

12

27

7E

WELL NO.

#4 Worrell

FARM

COMPANY

White & Ellis

CONTRACTOR

Co Tools


Seward

____ FT. FROM N. LINE

____ FT. FROM S. LINE

____ FT. FROM E. LINE

____ FT. FROM W. LINE

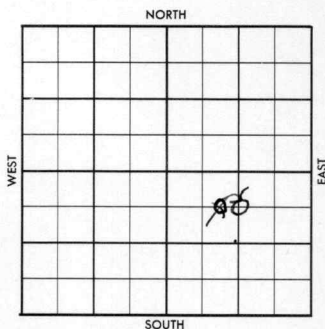

C N/2 SE

~~C E/2 NW SE~~

ELEVATION

1956

REPORT

9-12

Comm 9-10-56

8" @ 104/ w/70

Drlg 391 Rig #3

County Butler Elev. _____
 Sec. 12 Twp. 27 Rge. 7E
 Company White & Ellis
 Farm Name Worrell No. 4

TOPS	DEPTH	LOG	DATUM	Loc. in Sec.
Anb.				C E/2 NW SE
Tr.				
H.				
Tr.				
Dg.				
Bl.				
L.				Geol.
K.C.				Contr.
B.K.C.				Co. tools
Ce.				Pool
C.				Seward
M.				
M.				
K.				
Mz.				
Mq.				
V.				
S.				
S.				
A.				
R.				
Pe.				
G.				
T.D.				

SEP 12 56	
FIRST REPORT	

Date Comm. 9/10/56

8" @ 104 w/70, Drlg. 391, rig #3

~~30~~

CORRECTION

CORRECTION

FORM 513 SUNRAY

County Butler

Elev.

1532

Sec.

12

Twp.

27

Rgs.

7E

Company

White & Ellis

Farm Name

Worrell

No.

TOPS	DEPTH	LOG	DATUM
Anh.			
Tr.			
H.			
Tr.			
Dg.			
Bl.			
L.	<u>1768</u>		
K.C.	<u>2076</u>		
B.K. <u>Bartl.</u>	<u>2698</u>		
Ce.			
C.			
M.			
M.			
K.			
Mz.			
Mo.			
V.			
S.			
S.			
A.			
R.			
Pe.			
G.			
TD	<u>2716</u>		

CN2 SE
Loc. in Sec.CE/2 NW SE660' FNL-1320' FW

Geol.

Contr.

Co. tools

Pool

Seward

COMPLETE

Date Comm. 9/10/56

OCT 10 1956

8" @ 104 w/70, Drlg. 391, rig #3 SEP 19 '56satur. @ 2712 5 1/2 @ 2714 w OCTSEP 26 '56 DD 2731 TD TB 660+ 1 1/2 Gwph To Frac.

OCT 3 '56

\$ 2d POP

OCT 10 '56

P. 25Bo + 50.70 w 24 hrs.