

KANSAS


Barton

Section 24 Township 20 Range 12W

Well No. 5 Buckbee "A"

Company Bridgeport

Marchand Pool  
NORTH

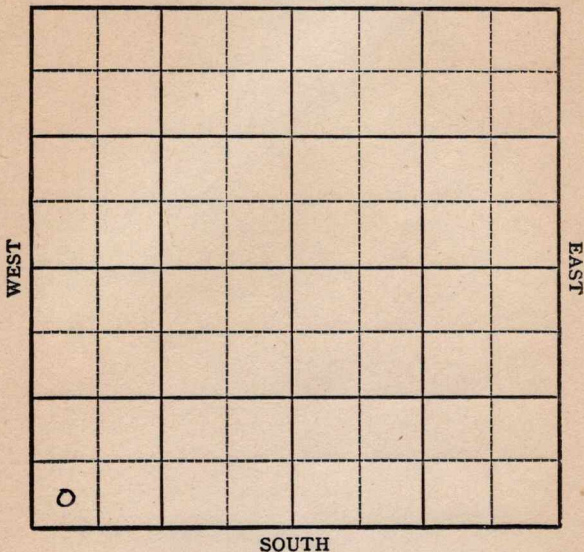

KANSAS

Barton

Sec. 24 Twp. 20 R. 12-W

Well No. #5 Buckbee "A" Farm \_\_\_\_\_

Bridgeport

Company \_\_\_\_\_

Marchand


\_\_\_\_\_ Ft. from N. Line

330 Ft. from S. Line

\_\_\_\_\_ Ft. from E. Line

330 Ft. from W. Line

SW/C

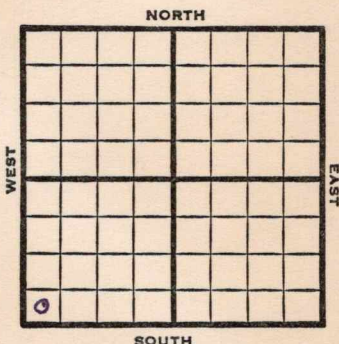

1948 Elev. 1814' REPORT

10/6 RUR

10/13 8" @ 250'  
Drlg. 2810'

10/19 Lansing 3120'  
Arbuckle 3345'  
TD 3348'  
5" @ 3347'

10/26 TD 3361'  
1000 acid swb 33 bbls oil 5 hrs.

11/3 "

11/10 Arb 3345'  
5" @ 3347  
1000 acid  
Pump 272 oil Pot.  
Gr. 41  
TD 3361'

COMPLETED

Map No. \_\_\_\_\_ Sec. 24 Twp. 20 R. 12W

Well No. 5 Buckbee "A"

Bridgeport

Company

**FIRST REPORT**

Contractor

SW/C

**SECTION PLAT**

\_\_\_\_\_ Ft. from N. Line

330 Ft. from S. Line

\_\_\_\_\_ Ft. from E. Line

330 Ft. from W. Line


Barton County

Location \_\_\_\_\_

Rig up \_\_\_\_\_

Drilling and Remarks:

R U R

**RECORD**

Cased \_\_\_\_\_ in., \_\_\_\_\_ ft.

Sand \_\_\_\_\_

Gas \_\_\_\_\_

Oil \_\_\_\_\_

Total Depth \_\_\_\_\_

**PRODUCTION**

1st 24 hrs. Nat. \_\_\_\_\_

1st 24 hrs. after shot \_\_\_\_\_

Gas \_\_\_\_\_ Cu. Ft.

Dry Hole \_\_\_\_\_

Abandoned \_\_\_\_\_

Date

OCT 6 1948 19

S. J. LEWIS Scout

