Form 51-5M 5-37 Petrol


Ness

KANSAS

Section 19 Township 18 Range 25-W

Well No. #2 ~~#1~~ M B. Shiner

Company Oriental Oil

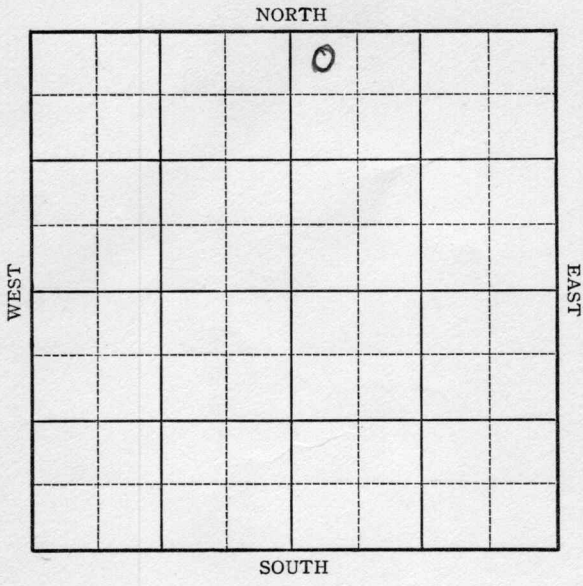

Form 252-A—5M—2-37—Palace KANSAS Ness

Sec. 19 Twp. 18 R. 25W

Well No. ~~1~~ M. B. Shiner #2 Farm


Oriental Oil Company

330 Ft. from N. Line

Ft. from S. Line

Ft. from E. Line

330 Ft. from W. Line

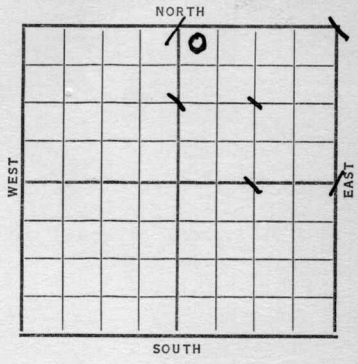

Date	REPORT
1937	
8/11	Cellar
8/20	Mat.
8/28	R. R.
9/3	S. H.
9/10	R. R.
9/17	Drlg. 350'.
9/24	10" @ 611'. Drlg. 1490'.
10/2	SD 1900'.
10/8	" "
10/15	" "
10/22	" "
10/29	" "
11/5	" "
11/12	" "
11/19	" "
11/26	" "
12/3	" "
12/10	" "
12/17	" "
12/24	" "
12/31	" "

OVER

1938

1/7 SD 1900'.

1/14 " "

1/20 " "

1/28 " "

2/4 " "

2/11 " "

2/18 " "

2/26 " "

3/4 " "

3/11 " "

3/18 " "

3/25 " "

4/1 " "

4/6 Abandoned at 1875'.

ABANDONED

Form 26—1M Eks.—2-29 Ness KANSAS

Map No. 77 Sec. 19 Twp. 18 R. 25W

Well No. 1 M. D. Shiner

Oriental Oil Company

Contractor

FIRST REPORT


330 Ft. from N. Line

Ft. from S. Line

Ft. from E. Line

330 Ft. from W. Line

SECTION PLAT

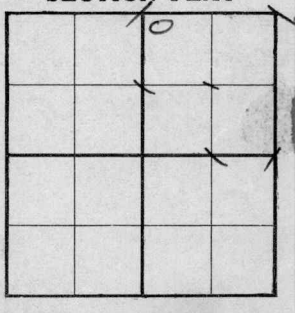

Location

Rig up

Drilling and Remarks:

Cellar

RECORD

Cased in., ft.

Sand

Gas

Oil

Total Depth

PRODUCTION

1st 24 hrs. Nat.

1st 24 hrs. after shot

Gas Cu. Ft.

Dry Hole

Abandoned

Date

AUG 11 1937 19

H. D. Hatfield Scout

Form 26—1M Bks.—2-29 Ness KANSAS

Map No. 77 Sec. 19 Twp. 18 R. 25 W

Well No. 2 - M. B Shiner

Oriental Oil Company

Contractor

CORRECTION


330 Ft. from N. Line

Ft. from S. Line

Ft. from E. Line

330 Ft. from W. Line

SECTION PLAT

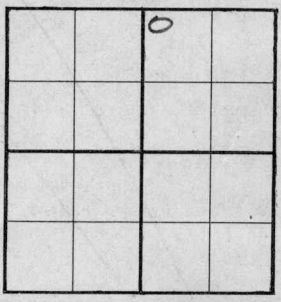

Location

Rig up

Drilling and Remarks:

first reported as #1. M. D. Shiner

Change to above

RECORD

Cased in., ft.

Sand

Gas

Oil

Total Depth

PRODUCTION

1st 24 hrs. Nat.

1st 24 hrs. after shot

Gas Cu. Ft.

Dry Hole

Abandoned

Date

NOV 23 1937 19

H. D. Hatfield Scout

Form 26—1M Bks.—2-29

KANSAS

Ness

Map No. 77 Sec. 19 Twp. 18 R. 25W

Well No. 2 M. D. Shiner

Oriental Oil Company

Contractor

ABANDONED

NW NE


330 Ft. from N. Line

Ft. from S. Line

Ft. from E. Line

330 Ft. from W. Line

SECTION PLAT

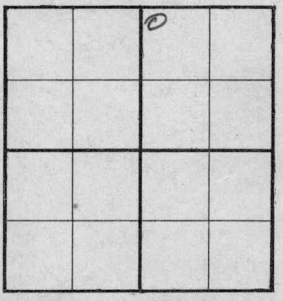

Location

Rig up

Drilling and Remarks:

abd @ 1875

RECORD

Cased in., ft.

Sand

Gas

Oil

Total Depth

PRODUCTION

1st 24 hrs. Nat.

1st 24 hrs. after shot

Gas Cu. Ft.

Dry Hole

Abandoned

Date

APR 6 - 1938 19 H. D. Hatfield Scout