
NESS

Form 51—5M—3-35—Mid-West

Map No. KANSAS Sec. 13 Twp. 18 R. 26-W

Well No. 1-G.J. Thompson Farm

Continental Oil Company

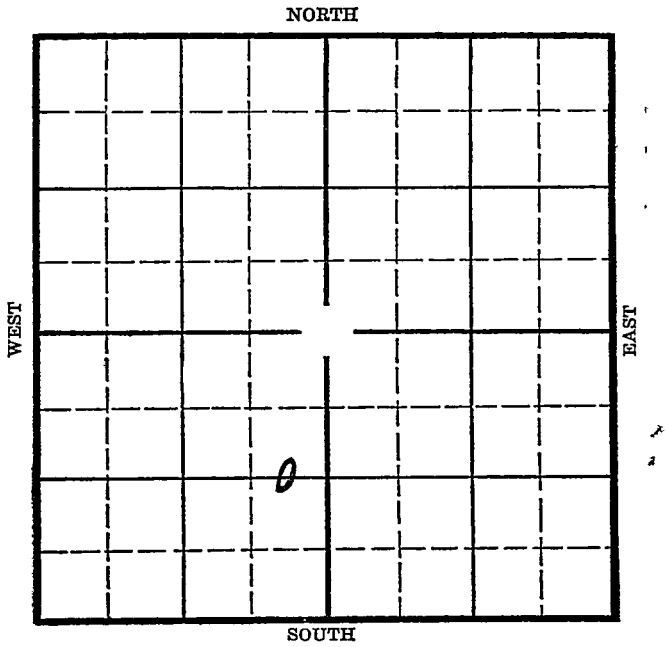

Location

Drilling Remarks

Rig Up

Drilling Remarks

RECORD

Cased in. ft.

Sand

Gas

Oil

Total Depth

PRODUCTION

1st 24 hrs. Nat.

1st 24 hrs. after shot

Gas cu. ft.

Dry Hole


Abandoned

Form 252-A
5M 7-35 MPC

Map No. KANSAS Sec. 13 Twp. 18 R. 26W

Well No. 1 H. J. Thompson Farm

Continental Oil Company

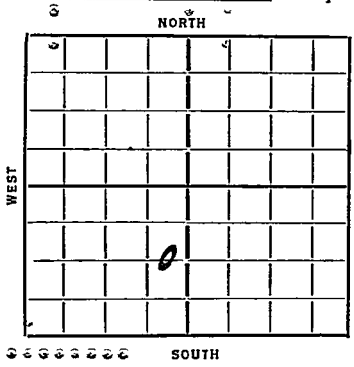

_____ Ft. from N. Line

1320 Ft. from S. Line

440 Ft. from E. Line

_____ Ft. from W. Line

Elev. 2565

Date	REPORT 7" 3445
~~1936~~ 3/18	Location.
3/20	--
3/27	B.R.
4/2	Rign.
4/10	16"@ 158'
4/16	Drlg. 2100'
4/23	Drlg. 2675'
4/30	Drlg. 2890'
5/7	K.C. 3090', 7" @ 3445'. W.O.C.
5/14	[redacted]'. S.O. Cleaning out.
5/21	--
5/28	T.D. 3455'-1350' oil in 36 hours.
6/4	Swab 150 bbls a day. (Teleg)
6/16	Potential 550 bbls. after acidization
6/25	--
7/2	T.D. 4505'. 3400' oil in hole.
7/9	2½ BW 3525'-27'. P.B. 4525'.
7/16	P.B. 4492'. water shut off. Testg.
7/23	2000 gallons acid. Testing.
7/30	Shut down.
8/6--8/13--8/20--8/27--9/3--	

(over)

9/9/36-Miss. Lime. 4447'.
T.D. 4505'.
P.B. 4492'.
2000 gallons of acid.
Pump 684 bbls of oil.

COMPLETED

Continental Geol. Dept. Tops:

Top Lansing.....3890'
Top Conglomerate...4430
Top Mississippi....4446

Form 26—M Rev. 8-28

KANSAS

Map No. 77 Sec. 13 Twp. 18 R. 26W


Well No. 1 G. J. Thompson

Continental Oil Company

Contractor

FIRST REPORT

SECTION PLAT

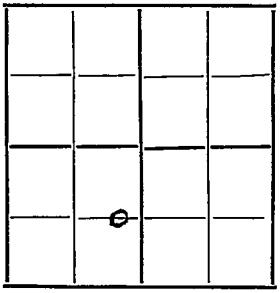

1320 Ft. from N. Line

Ft. from S. Line

440 Ft. from E. Line

Ft. from W. Line

Location ✓

Rig up

Drilling and Remarks:

RECORD

Cased in., ft.

Sand

Gas

Oil

Total Depth

PRODUCTION

1st 24 hrs. Nat.

1st 24 hrs. after shot

Gas Cu. Ft.

Dry Hole

Abandoned

Date

3-18-36 192

ORVAL MANNSCHRECK Scout

Form 88—1M Bks.—2-29 KANSAS


Map No. 77 Sec. 13 Twp. 18 R. 26W

Well No. 1 G. J. Thompson

Continental Company

Contractor

SECTION PLAT

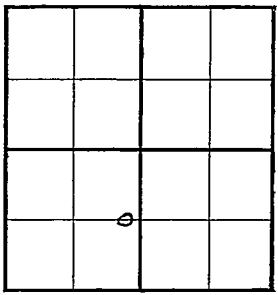

Ft. from N. Line

1320 Ft. from S. Line

440 Ft. from E. Line

Ft. from W. Line

COMPLETED

Location

Rig up

Drilling and Remarks:

Miss Lime 4444

PB 4492.

2000 acid

Pump 68 4 Hrs

RECORD

Cased in., ft.

Sand

Gas

Oil

Total Depth 4505

PRODUCTION

1st 24 hrs. Nat.

1st 24 hrs. after shot

Gas Cu. Ft.

Dry Hole

Abandoned

Date

SEP 9 1936 19

S. J. LEWIS

Scout