


Section 24 Township 20 Range 12W

Well No. #4 York Marchand

Company Phillips Petroleum

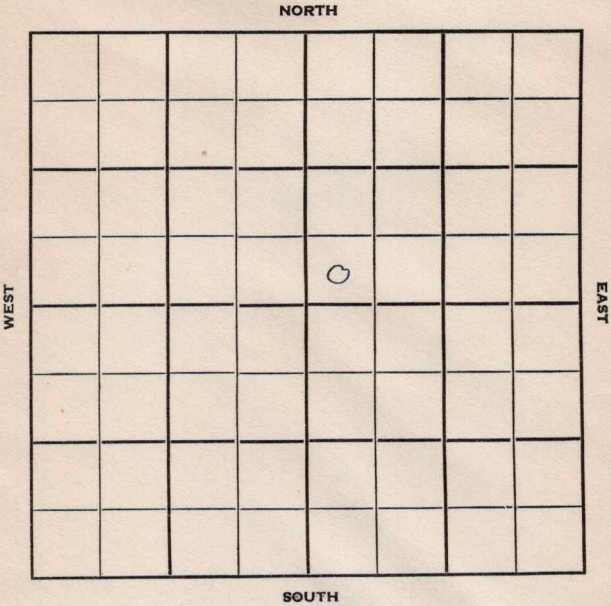

Barton

KANSAS

Sec. 24 Twp. 20 R. 12 W

Well No. # 4 York Marchand Farm

Phillips Petroleum Company

Hilton Contractor
Marchand


Ft. from N. Line

330 Ft. from S. Line

Ft. from E. Line

330 Ft. from W. Line

SW SW NE

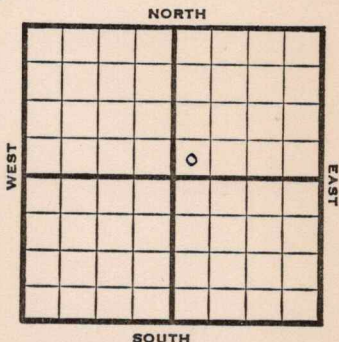

1951

Elev. 1803'

REPORT

10/17

Location

12/19

Spud 10-30-51

Oil well TD 3363' 8" @ 304'

Howard 2702'

Top 2726'

Heeb 2968'

Tor. 2984'

Br. lime 3094'

Lans. 3109'

Arb. 3338-40'

5" @ 3339' CO to 3340 10 GOPH

DD 3347' 15 GOPH 500 A S/1-3/4

BO 3 hr. 1000 A S/7-3/4 BO

DD 3360' FU 275' oil 5 hr.

S/8 1/2 BO 1/2 hr. 2000 A

S/10 BO 7 BW 2 hr. DD 3363'

S/13 1/2 BO 5 BW 4 hr.

Comp. 60 BOPD 10 BW

COMPLETED

County Barton State KansasSec. 24 (Blk.) 20 (Sur.) 12W Map No.Operator Phillips PetroleumWell No. 4 Farm York MarchandElev. Location SW SW NE

330 Ft. From S Line NE330 Ft. From W Line Quarter1st. Report OCT 1^p 1951

Completion

Remarks

Hilton - Contr.

Spudding Date

Drlg. Data Marchand

Location

J. E. TYRA

J. E. TYRA