

KANSAS

Form 51—5M—7-40—Palace


Barton

Section 24 Township 20 Range 12-W

Well No. 2 Scheufler

Company Continental

NORTH Marchand Pool

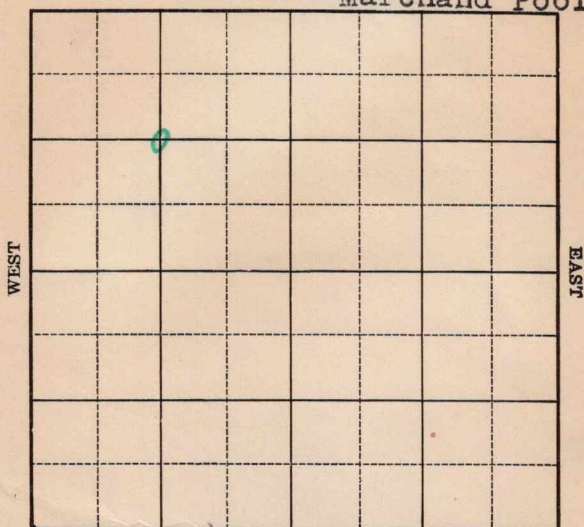


SOUTH

Sec. 24 Twp. 20 R. 12-WWell No. #2 Scheufler FarmContinental Company

(Marchand)

1320 Ft. from N. Line Ft. from S. Line Ft. from E. Line1320 Ft. from W. Line

Elev. 1810

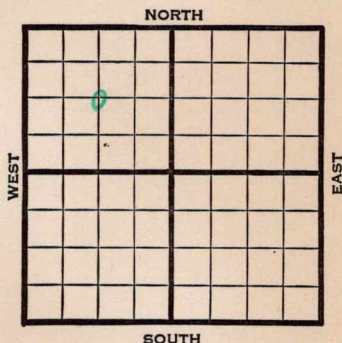

1941

REPORT

1/8 10" - 258' WOC.

1/16 Drlg. 2226'

1/23 Arb. 3322-25' T.D. 6" - 3323'

RUST.

1/30 T.D. 3350' Swab 26 oil in 3
hours.

2/5 Arb. 3322'

6" - 3323'

T.D. 3350'

2000 acid.

Echometer potential 1484 bbls.

40.5 Gravity

COMPLETED

Map No. 46 Sec. 24 Twp. 20 R. 12WWell No. 2 ScheuflerContinental

Company

Contractor


FIRST REPORT

C NW

1320 Ft. from N. Line Ft. from S. Line Ft. from E. Line1320 Ft. from W. Line

MARCHAND POOL

SECTION PLAT

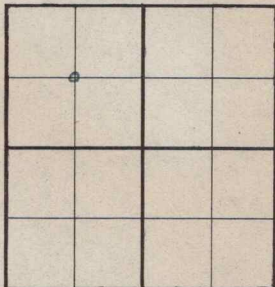Location Rig up

Drilling and Remarks:

10"-258'

WOC

RECORD

Cased in., ft.Sand Gas Oil Total Depth

PRODUCTION

1st 24 hrs. Nat. 1st 24 hrs. after shot Gas Cu. Ft.Dry Hole Abandoned

Date


JAN 8 194119S. J. LEWIS Scout

Map No. 46 Sec. 24 Twp. 20 R. 12WWell No. 2 ScheuflerContinental

Company

COMPLETED

Contractor

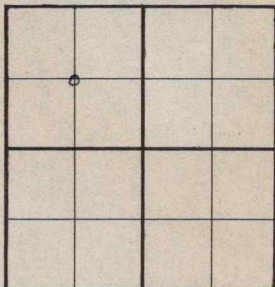SECTION PLAT

C NW

1320 Ft. from N. Line Ft. from S. Line Ft. from E. Line1320 Ft. from W. Line

MARCHAND POOL

Location Rig up

Drilling and Remarks:

*Ar & 3322**6" @ 3323**2000 cu ft**Echo Rd & 1484**40.5 Gr.***RECORD**Cased in., ft.Sand Gas Oil Total Depth 3350**PRODUCTION**1st 24 hrs. Nat. 1st 24 hrs. after shot Gas Cu. Ft.Dry Hole Abandoned

Date

FEB 5 1941 19S. J. LEWIS

Scout