


Section 24 Township 20 Range 12-W

Well No. #1 Scheufler

Company G-M-R Oil

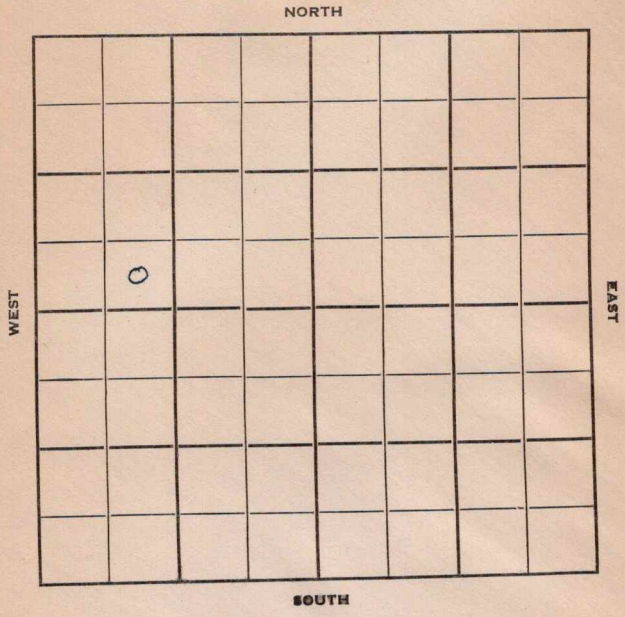

Barton

KANSAS

Sec. 24 Twp. 20 R. 12W

Well No. #1 Scheufler Farm

G-M-R Oil

Company

G-M- R Oil

Contractor

Silica Pool

Ft. from N. Line

330'


Ft. from S. Line

Ft. from E. Line

990'

Ft. from W. Line

SE SW NW

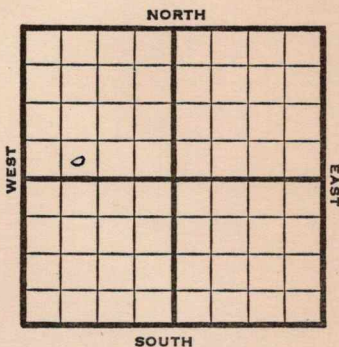

1950

Elev 1807

REPORT

9/20

Location

10/25

Spud 9-22-50

8 5/8" @ 224

Lans 3116

Arb 3334-37

5" @ 3335

TD 3340

1/2 boph 500 A

DD 3361 no inc

DD 3362

1500 A

FU 1200' oil 10 hr

Comp 248 bopd

Completed TD 3362

COMPLETED

County Barton State KansasSec. 24 (Blk.) 20 (Sur.) 12W Map No.Operator G-M-R OilWell No. 1 Farm ScheuflerElev. Location SE SW NW

330 Ft. From S Line NW990 Ft. From W Line Quarter1st. Report SEP 20 1950

Completion


Remarks

Continental farmout

Spudding Date

Drlg. Data Silica PoolLocation

J. E. TYRA

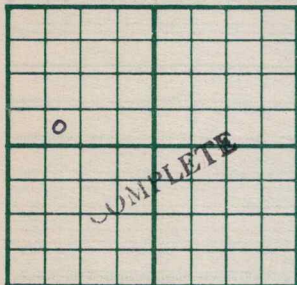County Barton State KansasSec. 24 (Blk.
Twps.) 20 (Sur.
Rge.) 12W Map No.Operator G-M-R OilWell No. 1 Farm ScheuflerElev. 1807 Location SE SW NW330 Ft. From S Line NW990 Ft. From W Line Quarter1st. ReportCompletion OCT 25 1950Remarks Silica PoolG-M-R - Contr.Spudding Date 9-22-50Drlg. Data Oil well TD 33628 5/8" @ 224 Lans. 3116 Arb. 3334-375" @ 3335 TD 3340 1/2 boph 500 ADD 3361 no inc. DD 3362 1500AFU 1200' oil 10 hr.Comp. 248 bopd