

Section 24 Township 20 Range 12-W

Well No. 3 Scheufler


Company Continental

Marchand Pool

NORTH

WEST

EAST

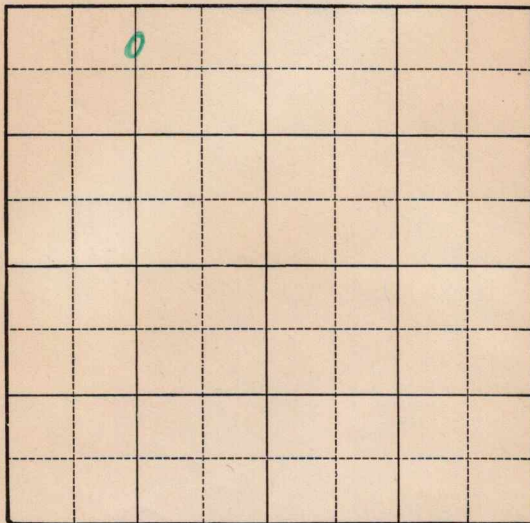

SOUTH

Map No. 46 Sec. 24 Twp. 20 R. 12W

Well No. 3 Scheufler

Continental Company

Contractor

FIRST REPORT

C N L NW

440 Ft. from N. Line


_____ Ft. from S. Line

_____ Ft. from E. Line

1320 Ft. from W. Line

MARCHAND POOL

SECTION PLAT

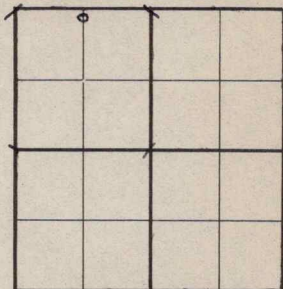

Location _____

Rig up _____

Drilling and Remarks:

Derrick

RECORD

Cased _____ in., _____ ft.

Sand _____

Gas _____

Oil _____

Total Depth _____

PRODUCTION

1st 24 hrs. Nat. _____

1st 24 hrs. after shot _____

Gas _____ Cu. Ft.

Dry Hole _____

Abandoned _____

Date

JAN 15 1941

19

S. J. LEWIS

Scout

Map No. _____ Sec. 24 Twp. 20 R. 12W

Well No. 3 Scheufler

Continental Company

Contractor

COMPLETED

C N L NW

440 Ft. from N. Line

_____ Ft. from S. Line

_____ Ft. from E. Line

1320 Ft. from W. Line

MARCHAND POOL

SECTION PLAT

Location _____

Rig up _____

Drilling and Remarks:

Core 3314

7" @ 3315

Echo P 13675

May 3000

405 Gr

RECORD

Cased _____ in., _____ ft.

Sand _____

Gas _____

Oil _____

Total Depth 3320

PRODUCTION

1st 24 hrs. Nat. _____

1st 24 hrs. after shot _____

Gas _____ Cu. Ft.

Dry Hole _____

Abandoned _____

Date

FEB 19 1941 19

S. J. LEWIS Scout