



Map No. KANSAS Sec. 16 Twp. 18 R. 16<sup>w</sup>

Well No. 1- Bredde Farm

Flynn et al Company


1320 Ft. from N. Line

\_\_\_\_\_ Ft. from S. Line

1320 Ft. from E. Line

\_\_\_\_\_ Ft. from W. Line

1931

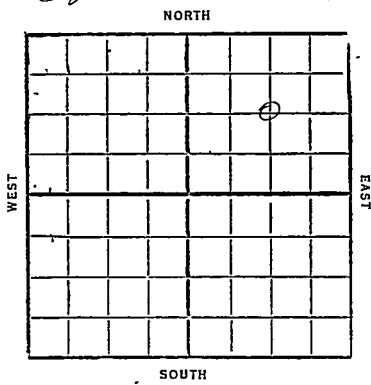

Date	REPORT
12/16	Clear
12/22	—
12/30	—
1932	—
1/6	—
1/13	—
1/20	Bldg rig
1/27	rig
2/3	—
2/10	—
2/17	—
2/26	—
3/2	Pit
3/9	V Chem 15"-360'
3/16	—
3/22	—
3/30	Setg 12"-987'
4/6	drg 1320"
4/13	Setg 10"-1975'
4/20	8"-1984
	8"-2350
	Cleaning out

4/27- show gas 2945  
dry 3010'  
5/4- 6"-3160  
Rng ~~8~~-3250'  
5/11- 6"-3240  
dry 3275  
5/18- HFW 3320-43  
6"-3347  
dry 3400'  
5/25 6"-3433  
Top Gas sand 3468-85  
Est 10 ft gas  
6/1- Cured 6 5/8"-3433  
Sand 3468-3501  
TD. 3501  
45 ft gas  
Comp.

*Russ*

74 KANSAS Map No. Sec. 16 Twp. 18 R. 16<sup>w</sup>

Well No. 1 *Burde*

*Flynn & al* Company

Contractor

**FIRST REPORTS**

**SECTION PLAT**

1370 Ft. from N. Line

..... Ft. from S. Line

1370 Ft. from E. Line

..... Ft. from W. Line


Location.....

Rig up.....

Drilling and Remarks:

*Cellar*

**RECORD**

Cased.....in., .....ft.

Sand.....

Gas.....

Oil.....

Total Depth.....

**PRODUCTION**

1st 24 hrs. Nat.....

1st 24 hrs. after shot.....

Gas.....Cu. Ft.

Dry Hole.....

Abandoned.....

Date DEC 16 1931 CHAS. L. SHERWOOD

192.....

Scou.....

*8386*

**74 KANSAS**

Map No. \_\_\_\_\_ Sec. 16 Twp. 18 R. 16 w

Well No. 1 Buddle

Flynn & #1 Company

Contractor

**COMPLETED**


**SECTION PLAT**

1320 Ft. from N. Line

\_\_\_\_\_ Ft. from S. Line

1320 Ft. from E. Line

\_\_\_\_\_ Ft. from W. Line

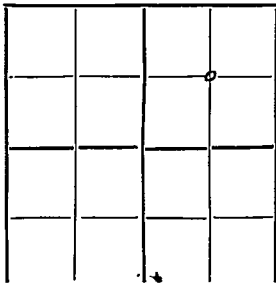

Location \_\_\_\_\_

Rig up \_\_\_\_\_

Drilling and Remarks:

**RECORD**

Cased 6 7/8 in., 34.33 ft.

Sand 3468-3501

Gas \_\_\_\_\_

Oil \_\_\_\_\_

Total Depth: 3501

**PRODUCTION**

1st 24 hrs. Nat. \_\_\_\_\_

1st 24 hrs. after shot \_\_\_\_\_

Gas 45 Cu. Ft.

Dry Hole \_\_\_\_\_

Abandoned \_\_\_\_\_

Date

**JUN 1 1932**

192

**CHAS. L. SHERWOOD**

Scout