

O. W. P. B.

Barton
18

KANSAS

11W

Section 32 Township _____ Range _____

Well No. #3 Schlochtermeyer

Company Texas Company

NORTH

					0		

WEST

EAST

SOUTH


O. W. P. B.

Barton

KANSAS ✓

Sec. 32 Twp. 18 R. 11W ✓Well No. #3 Schlochtermeyer FarmTexas Company CompanyBraden Drlg. ContractorN. Bieberle Pool990 Ft. from N. Line Ft. from S. Line Ft. from E. Line990 Ft. from W. Line

SE NW NE

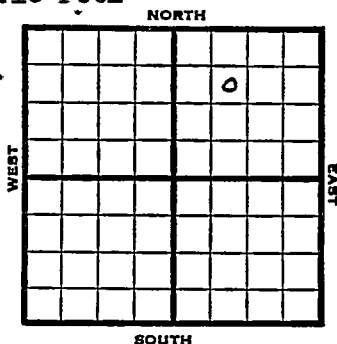

1953

Elev. 1831'

REPORT

6/3

Spud 5-30-53

10" @ 654'

WOC

6/10

Heeb 2979, Br. L. 3095, Lans 3111
 DST 3125-50 $1\frac{1}{2}$ hr, 60' gas, 30' M
 55# Drdg.

7/15

Spud 5-30-53 Oil well TD 3443'
 10" @ 654' Heeb 2979 Br line 3095
 Lans. 3111
 DST 3125-50 open $1\frac{1}{2}$ hr rec 60' gas,
 30' mud, 55#
 DST 3163-93 open $1\frac{1}{2}$ hr rec 3' mud 0#
 Arb. 3419
 DST 3420-33, open $1\frac{1}{2}$ hr rec 5' oil,
 25' MCO 890# TD 3433 7" @ 3432
 CO to 3433 DD 3443 8 GO 23 GWPH
 500 A 13 BWPH scum oil 5 hr.
 PB 3430 16/3425-29 500 A 1 BO
 3 BWPH 7 hr. P/7 BO 83 BWPD
 Comp. 9 BOPD 84 BW

COMPLETED**OVER**

1953
10/28

O. W. P. B.

KC 3111' Cong 3373' Arb. 3419'
OTD 3443' 7" @ 3432 PB 3425
16/3420-24 250 A S/1.67 GO
1 BW 20 min. 27 GO 69 GW 3 hrs.
500 A S/3 BO 56 BW 9 hrs.
PB 3167 32/3138-46 2000 A
S & F/29 BO Died SI F/15 BO
in 20 min. F/88 BO $1\frac{1}{4}$ hr.
Died S & F/15 BO 15 min
F 69 BO 7 hrs., 25/64" Ck.
NR

11/4
11/11

11/18

Oil Well
TD 3443'
KC 3111', Cong 3373', Arb. 3419'
OTD 3443'
7" @ 3432
PB 3425
16/3420-24, 250A
S/1.67 go 1 bw 20 mins., 27 go 69 gw
3 hrs., 500A
S/3 bo 56 bw 9 hrs.
PB 3167
32/3138-46, 2000A
S & F 29 bo died,
SI
F/15 bo 20 mins.,
F/88 bo $1\frac{1}{4}$ hrs., died
S & F 15 bo 15 mins.
F/69 bo 7 hrs.
Comp. F/279 bopd

COMPLETED

J. G. McGEHEE

County Barton State Kansas
 Sec. 32 (Blk.) 18 (Sur.) 11W Map No. (Twp.) (Rge.)
 Operator Texas Company
 Well No. 3 Farm Schlochtermeyer
 Elev. 1834 Location SE NW NE

990 Ft. From N Line NE
 990 Ft. From W Line Quarter

1st. Report

Completion JUL 15 1953

Remarks N. Bieberle Pool
Braden Drlg. - Contr.

Spudding Date 5-30-53

Drlg. Data Oil well TD 3443

10" @ 654 Heeb. 2979 Br. lime 3095

Lans. 3111 DST 3125-50 open $1\frac{1}{2}$ hr.

Rec. 60' gas 30' mud 55# DST 3163-93

open $1\frac{1}{2}$ hr. Rec. 3# mud 0# Arb. 3419

DST 3420-33 open $1\frac{1}{2}$ hr. Rec. 5' oil

25' mco 890# TD 3433 7" @ 3432

CO to 3433 DD 3443 8 go 23 gwph

500 A 13 bwph scum oil 5 hr.

PB 3430 16/ 3425-29 500 A 1 bo

3 bwph 7 hr. P/ 7 bo 83 bwph

Comp. 9 bopd 84 bw

J. G. McGEHEE

J. G. McGEHEE

J. G. McGEHEE