

Barton

KANSAS

SECTION 33 TOWNSHIP 18 RANGE 11W

WELL NO. #1 Schlechtermeyer


COMPANY Wilkinson Drlg., Inc.

NORTH

S/2 SE NW

WEST

EAST

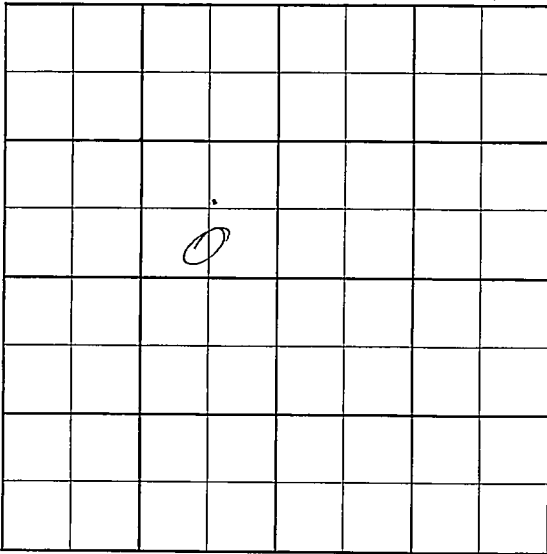

SOUTH

County Barton Elev. _____
 Sec. 33 Twp. 18 Rge. 11W
 Company Wilkinson Drlg. Inc.
 Farm Name Schlochtermeyer No. 1

TOPS	DEPTH	LOG	DATUM
Anh.	730		
TP.			
H.			
Tr.			
Dg.			
BL.			
L.			
K.C.			
B.K.C.			
Ce.			
C.			
M.			
M.			
K.			
Mz.			
Mo.			
V.			
S.			
S.			
A.			
R.			
PE.			
G.			
T.D.			

Loc. in Sec. _____

S/2 SE NW

Geol. _____

Contr. _____

Co. Tools _____

Pool _____

St. Peter

FIRST REPORT

MAY 1 57

Date Comm. 4-26-57 Texas DHM

8" @ 427/200, Drlg. 2170

Co.

Lse.

No.

Sec.

T.

R.

County Barton Elev. 1810
 Sec. 33 Twp. 18 Rge. 11W
 Company Wilkinson Drlg. Inc.
 Farm Name Schlochtermeyer No. 1

TOPS	DEPTH	LOG	DATUM	Loc. in Sec.
Anb.	730			S/2 SE NW
Tr.				
H.	2954			
Tr.				
Dg.				
BL.	3073			
L.	3088			
K.C.				Geol.
B.K.C.				Contr.
Ce.				Co. Tools
C.	3370			
M.				Pool
M.				St. Peter
K.				
Mz.				
Me.				
V.				
S.				
S.				
A.	3390			
R.				
PC.				
G.				
TD.	3397			COMPLETE

Date Comm. 4-26-57 Texas DHM
8" @ 427/200, Drlg. 2170 MAY 8 '57 DST
3093-3120 45" rel 20' md
BHP 944/20" 225/20" FP
40-53 DST 3134-73 1hr
2600' GIP rel 90' HGE' 50CM
+240' HGE' 0CM +120' SW
BHP 825/15" 5 1/2 3393/135
MAY 15 '57 W OCT MAY 22 '57 CO PD 3398
S.O. 1 1/2 no inc DD 3400 A

no inc DD 3403 & 1 1/2 Boph
 nolw 2 hrs decline to 1/2 Boph
 nolw 2 hrs 5.0 9 hrs FU 150'
 oil nolw 12 & 1 Boph nolw
 4 hrs DD 3413 TD & 1 Boph
 20% wt 4 hrs PB 2270
 16/3159-63 S.O. 1 & 2 3/4 Boph
 8% wt 4 hrs MAY 29 '57 PB 2245
 24/3115-19 1 & 8 1/2 Boph
 50% wt 4 hrs 12 CO
 3270 & 3 1/2 Boph + HWH
 10 hrs P.M. JUN 5 '57 JUN 12 '57 JUN 19 '57
 JUN 26 '57 JUL 3 '57 JUL 10 '57 JUL 17 '57 JUL 24 '57 AUG 21 '57
 P. 30 Bopd + 5 Bwpl. AUG 8 '57
 AUG 14 '57 AUG 21 '57 Phys Pup 1494'ox
 haws 3115-19
 3159-63