

31

31

5 E

Section _____ Township _____ Range _____

1 Shiflet

Well No. _____

Company E. H. Adair et al _____

NORTH

WEST

EAST

				0			

SOUTH

Cowley

KANSAS

SEC.	TWP.	R.
31	31	5E

WELL NO.

#1 Shiflet

FARM

COMPANY

E.H. Adair et al

CONTRACTOR

Wildcat.

330


Ft. from N. Line

Ft. from S. Line

Ft. from E. Line

330

Ft. from W. Line

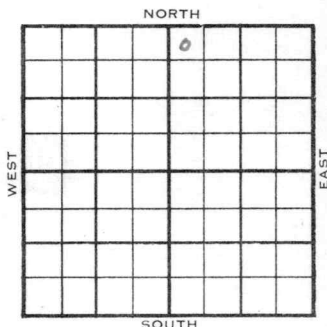

NW NW NE

C.S.O. - AC & DHM

1954

ELEVATION

1228'

REPORT

10/6

Spud 10-2-54

8" @ 84'

Drlg. 1903'

11/23

Spud 10-2-54 - D&A

TD 2996'

8" @ 84'

Layton 2282', Stal. 1858', KC 2383',

B KC 2517', Oswego 2664', Cherokee

2745', Bart 2917', Miss 2976'

DST 2983-90', opnl hr., rec. 120' gas,

80' ho&gcm, 60' SOCSW, 1135#

DST 2284-94', opn 1 hr., rec. 12' mud,

390#

DST 2321-48', opn 1 hr., rec. 480'

SQ&GCM, & SW, 1080' SW, 835#

5" @ 2985'

TD 2993'

CO to 2993'

FU 400' oil, 200' wtr, 1 bo 1 bwph

SD 16 hrs., FU 100' oil, 400' wtr.

B/2 bailers fluid ph 25% oil,

DD 2996, PB 2989', frac

S/50 bo 60 bwph VSSO

PB 2400'

24/2286-94, HFW 24/2354-58, CO to

2300 72/2285-97

Sd-oil-frac

B/ 14 bwph - D&A

ABANDONED

County Cowley State KansasSec. 31 (Blk.) 31 (Sur.) 5E Map No.Operator E. H. Adair et al.Well No. 1 Farm ShifletElev. Location NW NW NE


FIRST REPORT

330 Ft. From N Line NE330 Ft. From W Line Quarter1st. Report OCT 6 1954

Completion

Remarks C.S.O. - AC & DHMSpudding Date 10-2-54Drlg. Data Wildcat8" @ 84 drlg. 1903

FABEN GILSTRAP

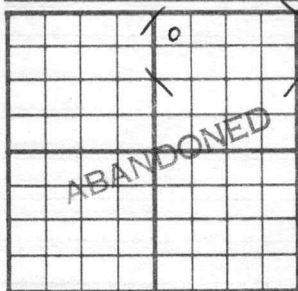County Cowley State KansasSec. 31 (Blk.) 31 (Sur.) 5E Map No.Operator E. H. Adair et al.Well No. 1 Farm ShifletElev. 1228 Location NW NW NE330 Ft. From N Line NE330 Ft. From W Line Quarter

1st. Report

Completion NOV 23 1954Remarks WildcatSpudding Date 10-2-54Drlg. Data D & A TD 29968" @ 84 Layton 2282 Stal. 1858KC 2383 B KC 2517 Oswego 2664Cherokee 2745 Bart. 2917 Miss. 2976DST 2983-90 open 1 hr. Rec. 120' gas80' ho & gcm 60' socsw 1135#DST 2284-94 open 1 hr. Rec. 12' mud390# DST 2321-48 open 1 hr. Rec.480' so & gcm & sw 1080' sw 835#5" @ 2985 TD 2993 CO to 2993 FU 400'oil 200' wtr. 1 bo 1 bwph SD 16 hr.FU 100' oil 400' wtr. B/ 2 bailersfluid ph 25% oil DD 2996 PB 2989frac S/ 50 to 60 bwph VSSO PB 240024/ 2286-94 HFW 24/ 2354-58 CO to 2300

FAREN OIL STRAP

Drlg. Data

72/ 2285-97 sd-oil-frac B/ 14 bwph

D & A

WTSC.

Place Map






NOV 23 1954