


DX 78-1 Barton

KANSAS

Section 33 Township 18 Range 11W

Well No. 3 T. Schlochtermeyer

Company Texas Co.

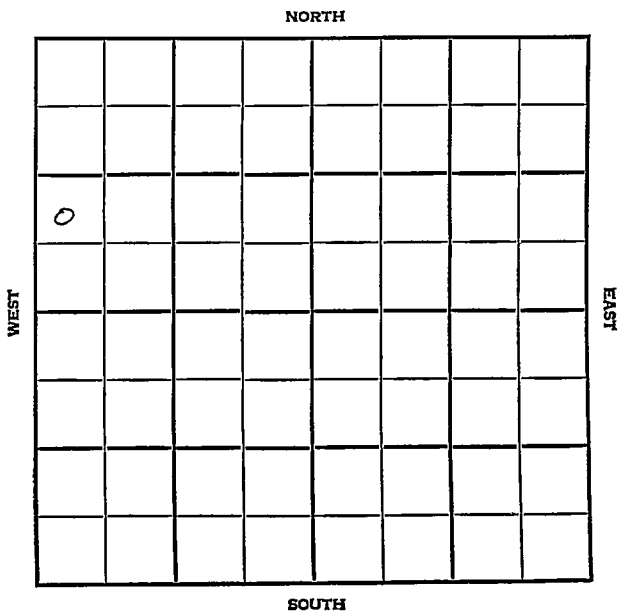

Barton

KANSAS

SEC.	TWP.	R.
33	18	11W

WELL NO
#3 T. Schlochtermeyer FARM

COMPANY
Texas Company

CONTRACTOR
Prime Drlg.

St. Peters Pool

_____ Ft. from N. Line

990 _____ Ft. from S. Line

_____ Ft. from E. Line

330 _____ Ft. from W. Line

NW SW NW

	0								

1955	ELEVATION	REPORT
	1823'	

4/27 Spud 4-25-55
Drlg. 655'

5/25 Spud 4-25-55 10-3/4" @ 644
7" @ 3433 CO to 3395
Perf 3282-96 3266-72
B/3 GWPH PB 3242' 2 BWPH
24/3170-76 29 GW 15 min.
Perf 3170-76 CO to 3166
20/3159-64 500 A
S/28 1/2 BO 4 bbl load oil 12 hr.
2000 A S/9 BO 170 BAW 7 hr.
F/135 BO 18 hr.
Comp. F/196 BOPD
Tops: Topeka 2707', Heebner Sh. 2968'
Brown lime 3081', Lansing 3098',
Congl. 3370', Arbuckle 3420',
TD 3435' - Comp.

COMPLETED

COMPLETED


FORM 513 REV. SUNRAY

County Barton Elev. 1823
 Sec. 33 Twp. 18 Rge. 11W
 Company Texas Company
 Farm Name T. Schlochtermeyer No. 3

TOPS	DEPTH	DATUM
Cim. Anhydrite		
Ft. Riley		
Howard		
Topeka	2707	884
Heebner Sh.	2968	1145
Toronto Ls.		
Brown Lime	3081	1258
Lansing	3098	1275
Kans. City		
B. K. C.		
Congl.	3370	1547
Miss.		
Kinderhook		
Misener		
Hunton		
Sylv. Maquo		
Viola		
Simpson		
Smp.		
Gorham		
Arbuckle	3420	1597
Basal Sand		
Pre. Cam.		
T. D.	3435	

Loc. in Section
NW SW NW

Drig. Contr. Prime
 Pool St. Peters

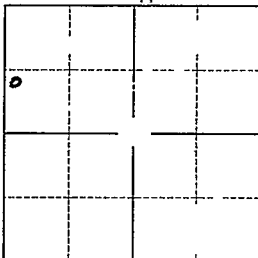

Date Comm.
 Date Comp. MAY 25 '55

Spud 4-25-55 10 3/4" @ 644
 7" @ 3433 CO to 3395 perf. 3282-96
 3266-72 B/ 3' gwph PB 3242 2 bwph
 24/ 3170-76 29 gw 15 min. perf. 3170-76
 CO to 3166 20/ 3159-64 500 A
 S/ 28 1/2 bo 4 bbl load oil 12 hr.
 2000 A S/ 9 bo 170 baw 7 hr.
 F/ 135 bo 18 hr. Comp/ F/ 196 bopd