

Section 33 Township 31 Range 5EWell No. #1 CraigCompany A. D. Krow

NORTH

							0

SOUTH

WEST EAST

Cowley

KANSAS

Sec. 33 Twp. 31 R. 5 E

Well No. # 1 Craig Farm

A. D. Krow Company

Lehman Contractor

Wildcat


Ft. from N. Line

990 Ft. from S. Line

330 Ft. from E. Line

Ft. from W. Line

NE SE NE

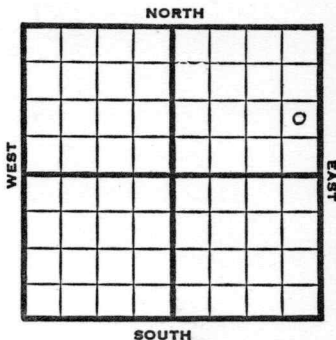

1951

Elev. 1267' REPORT

6/6

8/22

MICT

Spud 7-4-51

D&A TD 2625

13" @ 610

10" @ 1550

8" @ 1750

6" @ 2015

Layton 2325-55


KC 2417

TD 2625

D&A

ABANDONED

County **Cowley** State **Kansas**
Sec. **33** (Blk.) **31** (Sur.) **5E** Map No.
Operator **A. D. Krow**
Well No. **1** Farm **Craig**
Elev. Location **NE SE NE**

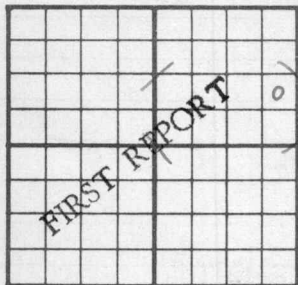

990 Ft. From **S** Line **NE**
330 Ft. From **E** Line Quarter
1st. Report **JUN 6 1951**

Completion

Remarks

Lehman - Contr.

Spudding Date

Drlg. Data

Wildcat

MICT

J. E. TYRA

County Cowley State Kansas
 Sec. 33 (Blk.) 31 (Sur.) 5 E Map No. (Twp.)
 Operator A. D. Krow
 Well No. 1 Farm Craig
 Elev. 1267 Location NE SE NE



990 Ft. From S Line NE
330 Ft. From E Line Quarter
 1st. Report _____
 Completion AUG 22 1951
 Remarks Wildcat
Lehman - Contr.
 Spudding Date 7-4-51

Drlg. Data D & A TD 2625
13" @ 610 10" @ 1550 8" @ 1750
6" @ 2015 Layton 2325-55 KC 2417
TD 2625 D & A