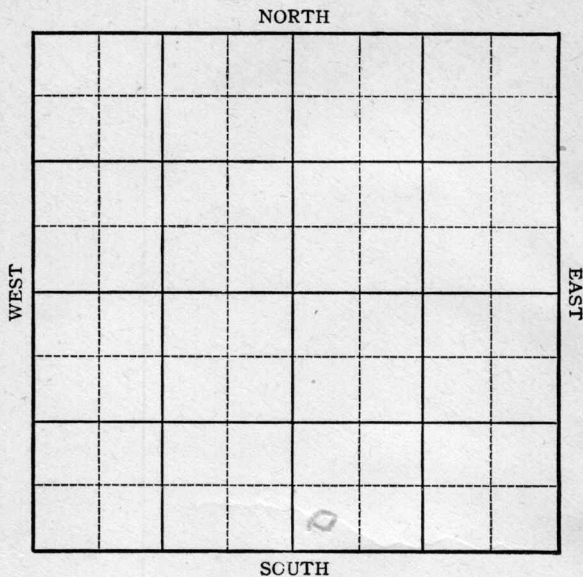


KANSAS

COWLEY

FORM 51 5M 11-44 PETROL

Section 33 Township 31 S Range 5 EWell No. #1 KROW ESTATECompany A. G. KROW

KANSAS

Cowley County

Sec. 33 Twp. 31 R. 5E

Well No. #1 Krow Estate Farm

A. G. Krow

Company

Miscellaneous

Ft. from N. Line

330


Ft. from S. Line

Ft. from E. Line

330

Ft. from W. Line

SW SE Elev. 1275

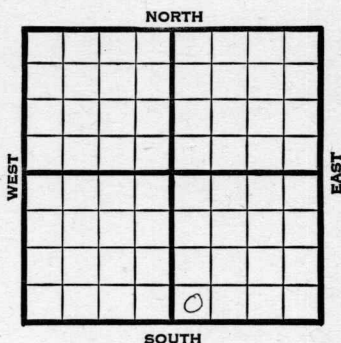

1945

REPORT

4/11 15" @ 500
12" @ 1000
10" @ 1630
8" @ 2000' OD
4/20 2118' S.D.
4/27 7" @ 2343' CO
5/2 KC 2440
TD 2591'

ABANDONED

Kansas Pool Name Miscellaneous

Map No. 2 Sec. 33 Twp. 31 R. 5E


Well No. 1 Krow Estate

A. G. Krow Company

FIRST REPORT Contractor

SW SE

SECTION PLAT

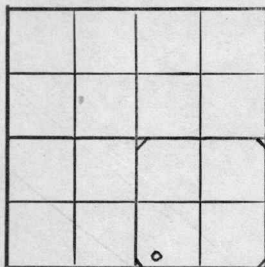

 Ft. from N. Line

330 Ft. from S. Line

 Ft. from E. Line

330 Ft. from W. Line

Cowley

Location

Rig up

Drilling and Remarks:

15" - 500
12" - 1000
10" - 1630
8" - 2000 OD

RECORD

Cased in., ft.

Sand

Gas

Oil

Total Depth

PRODUCTION

1st 24 hrs. Nat.

1st 24 hrs. after shot

Gas Cu. Ft.

Dry Hole

Abandoned

Date

APR 1 1 1945 19

S. J. LEWIS Scout

Kansas Pool Name MiscellaneousMap No. 2 Sec. 33 Twp. 31 R. 5EWell No. 1 Krow EstateA. G. Krow CompanyABANDONED Contractor

SW SE

SECTION PLAT

 Ft. from N. Line330 Ft. from S. Line Ft. from E. Line330 Ft. from W. LineCowley CountyLocation Rig up

Drilling and Remarks:

KC2440

RECORD

Cased in., ft.Sand Gas Oil Total Depth 2591

PRODUCTION

1st 24 hrs. Nat. 1st 24 hrs. after shot Gas Cu. Ft.Dry Hole Abandoned

Date

MAY 2 1945 19 S. J. LEWIS Scout