


DX 78-1 Barton

KANSAS

Section 34 Township 18S Range 11W

Well No. #2 Johanning

Company Nadel & Gussman

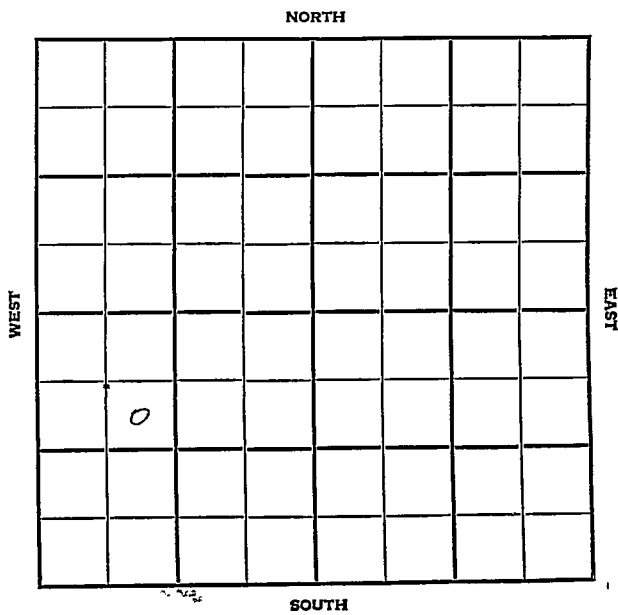

Barton

KANSAS


SEC. 34	TWP. - -18	R. 11W
------------	---------------	-----------

WELL NO. #2 Johanning FARM

COMPANY Nadel & Gussman

CONTRACTOR Reserve

_____ FT. FROM N. LINE
 _____ FT. FROM S. LINE
 _____ FT. FROM E. LINE
 _____ FT. FROM W. LINE

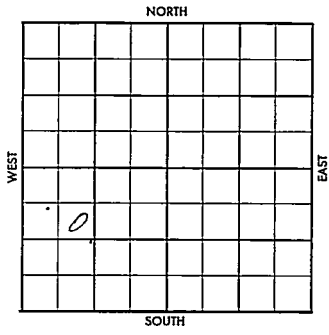

SE NW SW

1956	ELEVATION	REPORT
------	-----------	--------

8-1	Pits	
-----	------	--

County Barton Elev. 1800
 Sec. 34 Twp. 18S Rge. 11W
 Company Nadel & Gussman
 Farm Name Johanning No. 2

TOPS	DEPTH	LOG	DATUM	Loc. in Sec.
Anb.				SE 1/4 SW
Tr.				
Dg.				
Bl.	2931			
L.	3046			
K.C.	3063			Geol.
B.K.C.	3308			Contr.
Ce.				Reserve
C. <u>zn</u>	3359			
M. <u>cg heat</u>	3372			Pool
M.				
K.				
Mz.				
Mo.				
V.				
S.				
S.				
A.				
R.				
PE.				
G.				
TD.	3406			

COMPLET
 0
 SEP 19 '56

Date Comm.

Pits AUG 8 '56 8-1-56 85/8 300

1175 Fish @ 2873 AUG 15 '56

crd 3060-3160 Full rec 5 1/2

3405 AUG 22 '56 CO 28/3146-52

GSO 27/3132-36 5 1/2 Bop

no/w 4 hrs 12" "029 '56 Fluid

148 Bo no/w 90" Flw 17 Bop

no/w 12 hrs 3/8" ch. SEP 5 '56 SEP 12 '56

SEP 19 '56 Flw 393 Bopd no/w tr