


SECTION 34 TOWNSHIP 18 RANGE 11W

WELL NO. #4 Johanning

COMPANY Nadel & Gussman

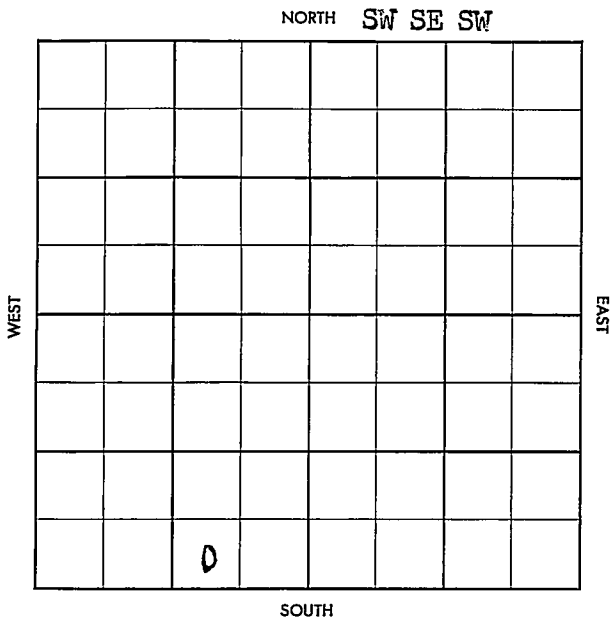

County Barton Elev. \_\_\_\_\_  
 Sec. 34 Twp. 18 Rgs. 11W  
 Company Nadel & Gussman  
 FarmName Johanning No. 4

Co.

TOPS	DEPTH	LOG	DATUM
Anh.			
Tr.			
H.			
Tr.			
Dg.			
Bl.			
L.			
K.C.			
B.K.C.			
Ce.			
C.			
M.			
M.			
K.			
Mz.			
Me.			
V.			
S.			
S.			
A.			
R.			
Pe.			
G.			
T.D.			

Loc. in Sec. SW SE SW  
 Geol. \_\_\_\_\_  
 Contr. Reserve Tool  
 Pool St. Peter E.

Log

FIRST REPORT	
FEB 20 1957	
0	

T

No.

Date Comm. W O R T

Sec.

T

R

~~13~~

1796 DF

County Barton Elevation 1799 12B  
 Sec. 34 Twp. 18 Rge. 11W  
 Company Nadel & Gussman  
 Farm Name Johanning No. 4

TOPS	DEPTH	LOG	DATUM	Loc. in Sec.
Anh.				SW SE SW
Tp.	2658			
H.	2922			
Tr.				
Dg.				
Bl.	3035			
L.	3054			Geol.
K.C.				Contr.
B.K.C.	3300			Reserve Tool
Ce.				Pool
C.				St. Peter E.
M.				
M.				
K.				
Mz.				
Mo.				
V.				
S.				
S.				
A.	3371			COMPLETE
R.				
PE.				MAY 8 '57
G.				
TD.	3399			

Date Comm.

W O R T 2-22-57 8 5/8  
 309/175 @ 2075 DST  
 2860-70 lhr 6-14" Flwd oil  
 in 56" no est BHP 1060/30"  
 5 1/2 @ 3397 MAR 13 '57 RUCT  
 MICT 22/3282-86  
 no Fluid 29/3232-36 1st 56 bph  
 1st & 2nd Flw 30 Boph no lws 5"  
 MAY 1 '57 X ~~OR~~ PH.P. 198 BOPD