


Section 36 Township 18 Range 11W


Well No. #1 Doll

Company S. M. Anderson

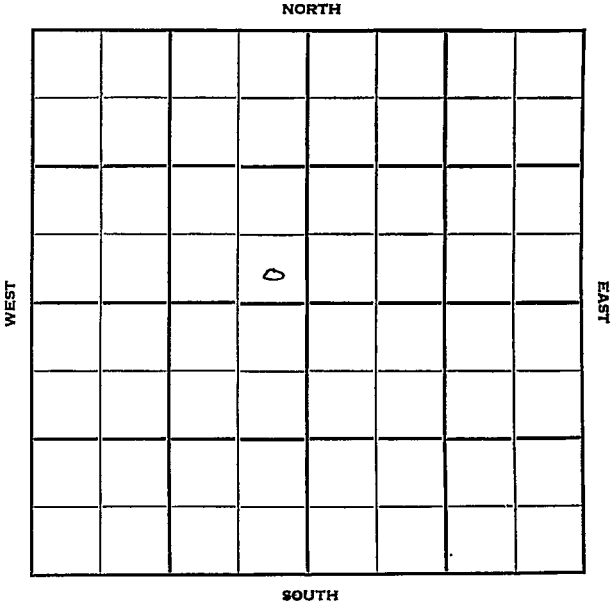

Sec. 36 Twp. 18 R. 11WWell No. #1 Doll FarmS. M. Anderson CompanyIsern ContractorMryida Ft. from N. Line330 Ft. from S. Line330 Ft. from E. Line Ft. from W. Line

NORTH

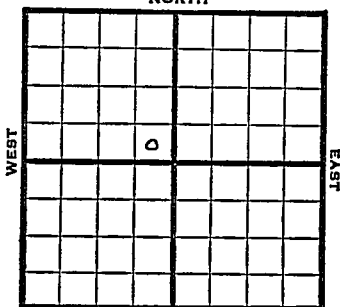

SOUTH

SE SE NW

1952 Elev. 1753' REPORT

2/6

Location

2/13

Drlg. 1500'

2/20

Heeb. 2840

Br Li 2957

Lans. 2980

DST 2983-3057 15 mins. 460' fluid, mostly O&GCM

DST 3065-71 1 hr. 30' SW Cong. 3265

Arb. 3292 5" @ 3293 TD 3295'

3/5

No report

3/11

P/ 8 BO & 30 BWPD

3/19

NR

3/25

"

4/1

"

4/9

"

4/16

Spud 2-9-52

Oil Well TD 3310 8" @ 218

Anhy 490-518

Heeb. 2840

Br Li 2957

Lans. 2980

DST 2983-3057 open 15 min. rec.

460' fluid

DST 3063-71 open 1 hr. rec. 30' SW

Cong. 3265

Arb. 3292

5" @ 3293 TD 3295 DD 3310

S/ 5 goph 500 A S/ 1 boph

8 hr. PB 3308 1500 A S/ 10 boph

2 bw 12 hr. P/ 80 bo 30 bwpd

Comp. 39 bopd 73% wtr.


COMPLETED

County Barton State Kansas
 (Blk.) (Sur.)
 Sec. 36 Twp. 18 Rge. 11W Map No.

Operator S. M. Anderson

Well No. 1 Farm Doll

Elev. Location SE SE NW

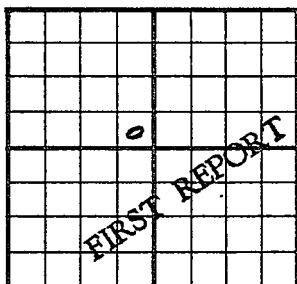

330 Ft. From S Line NW

330 Ft. From E Line Quarter

Ist. Report FEB 6 1952

Completion

Remarks

Isern - Contr.

Spudding Date


Drlg. Data

Mryda

Location

J. G. McGEHEE

County Barton State Kansas
 Sec. 36 (Blk.) 18 (Sur.) 11W Map No.
 Operator S. M. Anderson
 Well No. 1 Farm Doll
 Elev. 1753 Location SE SE NW

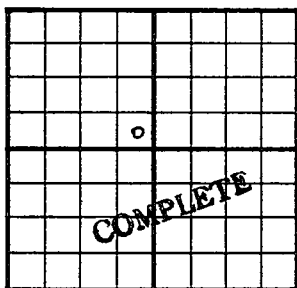

330 Ft. From S Line NW
330 Ft. From E Line Quarter
 1st. Report
 Completion APR 16 1952
 Remarks Mary Ida Pool
Isern - Contr.
 Spudding Date 2-9-52

Drlg. Data Oil well TD 3310
8" @ 218 Anhy 490-518 Heeb. 2840
Br. lime 2957 Lans. 2980 DST 2983-3057
open 15 min. Rec. 460' fluid
DST 3063-71 open 1 hr. Rec. 30' sw
Cong. 3265 Arb. 3292 5" @ 3293
TD 3295 DD 3310 S/ 5 goph 500 A
S/ 1 boph 8 hr. PB 3308 1500 A
S/ 10 boph 2 bw 12 hr. P/ 80 bo 30 bwpd
Comp. 39 bopd 73% water

J. G. McGEHEE