


Company Frank Taylor et al

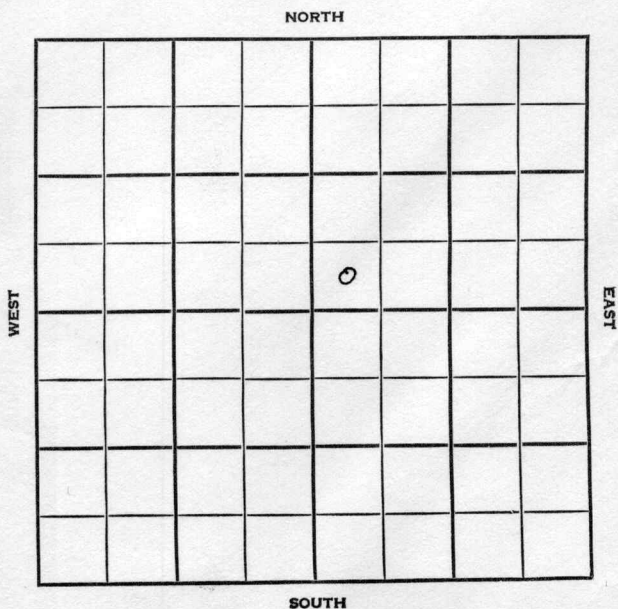

Cowley

KANSAS

SEC.	TWP.	R.
2	31	6E

WELL NO.

#1 Jabara

FARM

COMPANY

Frank Taylor et al

CONTRACTOR

Uhl Drlg.


_____ Ft. from N. Line

_____ Ft. from S. Line

_____ Ft. from E. Line

_____ Ft. from W. Line

SW SW NE

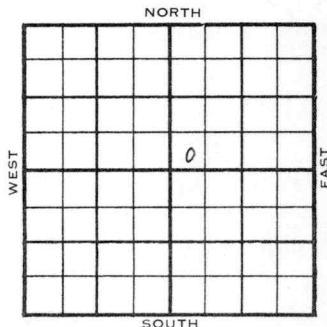

1955	ELEVATION	REPORT
9-14	Comm. 9-3-55 8 5/8" @ 80/65 DST 2503-13, open 1 hr., rec. 10' ocm 2' oil 0# Drlg. 2806' Stal 1747 Lakin 2177 L. 2189	
9-21	D & A Barts 2845 Miss 2926 T.B. 2980'	

ABANDONED

County Cowley Elev. _____ Co.
 Sec. 2 Twp. 31 Rge. 6E
 Company Frank Taylor et al.
 Farm Name Jabara No. 1

TOPS	DEPTH	LOG	DATUM	Loc. in Sec.
Anh.				SW SW NE
Tr.				
H. <u>Stal</u>	<u>1747</u>			
Tr. <u>Lakin</u>	<u>2177</u>			
Dg.				
Bl.				
L.	<u>2189</u>			
K.C.				Geol. _____
B.K.C.				Contr. _____
Ce.				Uhl Drlg.
C.				
M.				Pool
M.				
K.				
Mz.				
Mq.				
V.				
S.				
S.				
A.				
R.				
Pe.				
G.				
T.D.				

FIRST REPORT
 SEP 4 '55

Date Comm. 9-3-55
8 5/8" @ 80/65 DST 2503-13 open 1 hr.
Rec 10' ocm 2' oil 0# drlg. 2806

Use:

No.

Sec.

7.

