

Section 36 Township 18 Range 11 W

Well No. # 2 Doll

Company Strain Drilling Co.

NORTH

						0	

WEST

EAST

SOUTH

Barton
18

KANSAS

11W

Sec. 36 Twp. _____ R. 11W

Well No. #2 Doll Farm _____

Strain Drilling Co. Company _____

Contractor _____


990' Ft. from N. Line

_____ Ft. from S. Line

990' Ft. from E. Line

_____ Ft. from W. Line

SW NE SE

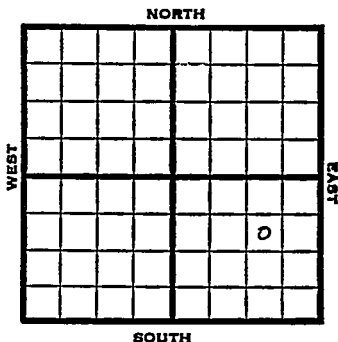

1951 Elev. 1753' REPORT

7/11 Drilling

8/15 Oil well TD 3338' Top 2556'
 DST 2761-75 open 1 hr. rec 120' SW
 Heeb 2821' Br. lime 2940' Lans 2951'
 DST 3020-49 open 1 hr. rec 90' HOCM
 100' O & GCM, 30' free oil.
 DST 3024-66 open 1 hr, rec 120' free
 oil.
 DST 3073-3110 open 1 hr. rec 25' SW
 DST 3134-56 open 1 hr. rec 145' HO &
 GCM
 Arb. 3305' TD 3317' 5" @ 3307'
 500 A Test $\frac{1}{2}$ BFPH DD 3338'
 no inc. PB 3173 40/3132-42
 S/10 BOPH 10% water 2000 A
 11 BFPH 10% water. SP 3120'
 20/3045-50 2000 A F/62 BO 1 hr.
 F/21 BOPH 4 hr.
 Comp. F/541 BOPD 1/2" choke

COMPLETED

