

KANSAS


FORM 51 5M 1-42 PETROL

Cowley

Section 36 Township 31 Range 5-E

Well No. #1 Lewis

Company Northern Ordnance

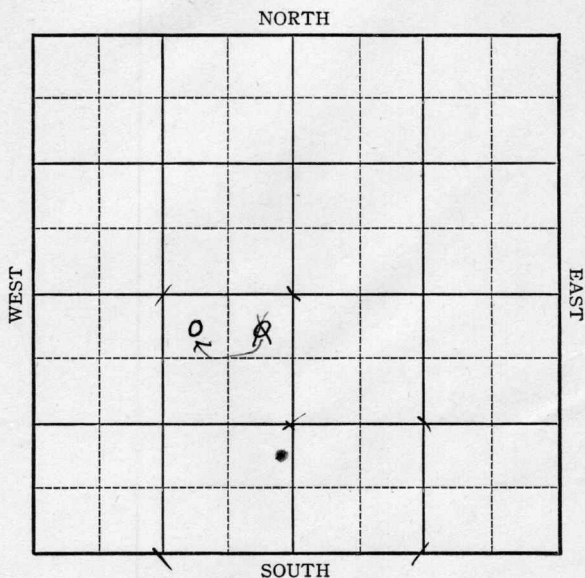

KANSAS

Cowley

Sec. 36 Twp. 31 R. 5-E

Well No. #1 Lewis Farm

Northern Ordnance Company

Miscellaneous


330 Ft. from N. Line

         Ft. from S. Line

330 Ft. from E. Line

         Ft. from W. Line

Elev. 1348

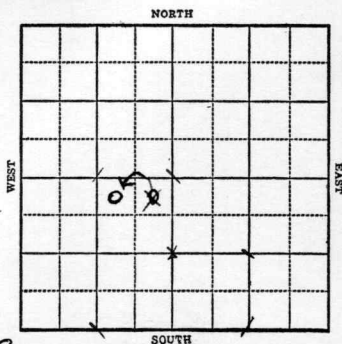

| 1943 | REPORT      |
|------|-------------|
| 6/23 | Machine     |
| 6/30 | "           |
| 7/7  | 15" @ 494'  |
| 7/15 | " "         |
| 7/21 | " "         |
| 7/28 | 12" @ 1213  |
|      | Drlg. 1525' |
| 8/4  | Drlg. 1790' |
|      | 10" @ 1785' |
| 8/11 | 8" @ 2019   |
|      | Drlg. 2065' |
| 8/18 | 2400' SD    |
| 8/25 | 6" @ 2690   |
|      | Drlg. 2790' |
| 9/1  | Miss 3070   |
|      | T.D. 3120'  |
|      | ABANDONED   |

Cowley

KANSAS

Map No. 2 Sec. 36 Twp. 31 R. 5EWell No. 1 LewisNorthern Ordnance

Company

FIRST REPORT

Contractor

NE SW


SECTION PLAT

330 Ft. from N. Line

Ft. from S. Line

330 Ft. from E. Line

Ft. from W. Line

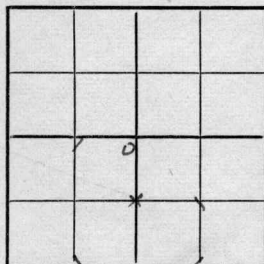

MISCELLANEOUS

Location

Rig up

Drilling and Remarks:

Machine

RECORD

Cased \_\_\_\_\_ in., \_\_\_\_\_ ft.

Sand \_\_\_\_\_

Gas \_\_\_\_\_

Oil \_\_\_\_\_

Total Depth \_\_\_\_\_

PRODUCTION

1st 24 hrs. Nat. \_\_\_\_\_

1st 24 hrs. after shot \_\_\_\_\_

Gas \_\_\_\_\_ Cu. Ft.

Dry Hole \_\_\_\_\_

Abandoned \_\_\_\_\_

Date

JUN 23 1943 19S. J. LEWIS

Scout

Cowley

KANSAS

Map No. 2 Sec. 36 Twp. 31 R. 5EWell No. 1 Lewis

Northern Ordnance

Company

CORRECTION

Contractor

NW NE SW


SECTION PLAT

330 Ft. from N. Line

Ft. from S. Line

990 Ft. from E. Line

Ft. from W. Line

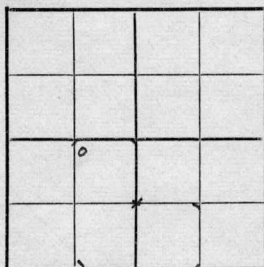

MISCELLANEOUS

Location

Rig up

Drilling and Remarks:

Reported

NE SW

RECORD

Cased \_\_\_\_\_ in., \_\_\_\_\_ ft.

Sand \_\_\_\_\_

Gas \_\_\_\_\_

Oil \_\_\_\_\_

Total Depth \_\_\_\_\_

PRODUCTION

1st 24 hrs. Nat. \_\_\_\_\_

1st 24 hrs. after shot \_\_\_\_\_

Gas \_\_\_\_\_ Cu. Ft.

Dry Hole \_\_\_\_\_

Abandoned \_\_\_\_\_

Date

JUL 7 1943 19

S. J. LEWIS Scout

Cowley

KANSAS

Map No. 2 Sec. 36 Twp. 31 R. 5EWell No. 1 LewisNorthern Ordnance CompanyABANDONED Contractor

NW NE SW

## SECTION PLAT

330 Ft. from N. Line         Ft. from S. Line990 Ft. from E. Line         Ft. from W. Line

|  |   |  |  |
|--|---|--|--|
|  |   |  |  |
|  |   |  |  |
|  | o |  |  |
|  |   |  |  |

MiscellaneousLocation                                 Rig up                                 

Drilling and Remarks:

*Miss 3078*

## RECORD

Cased                  in.,                  ft.Sand                                 Gas                                 Oil                                 Total Depth 3120

## PRODUCTION

1st 24 hrs. Nat.                                 1st 24 hrs. after shot                                 Gas                                  Cu. Ft.Dry Hole                                 Abandoned                                 

Date

SEP 1 1943 19S. J. LEWIS Scout