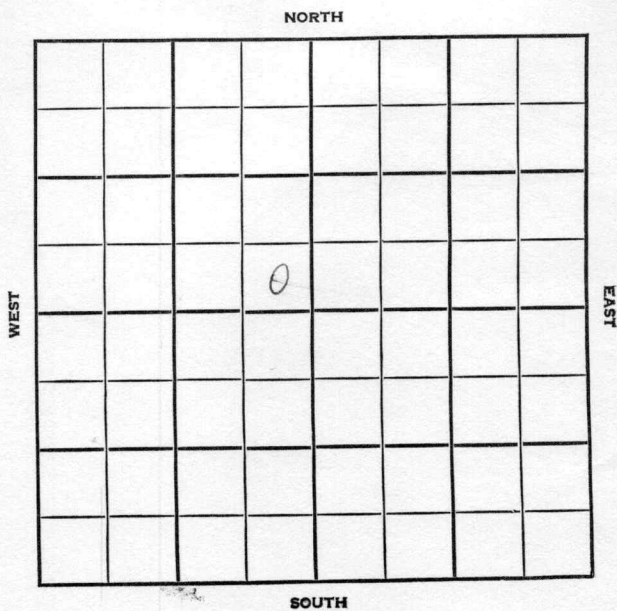


Section 3 Township 31 Range 6EWell No. #1 CrowleyCompany W. L. Hartman

SEC. 3 TWP. 31 R. 6E
COWLEY KANSAS

WELL NO.

#1 Crowley

FARM

COMPANY

W.L. Hartman

CONTRACTOR

Co. Tools

WILDCAT


FT. FROM N. LINE

FT. FROM S. LINE

FT. FROM E. LINE

FT. FROM W. LINE

SE SE NW

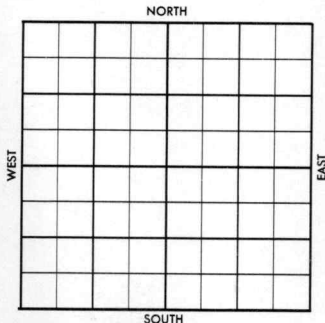

CSO - DHM

1956

ELEVATION

1393'

REPORT

5-29

Comm. 5-25-56

8" @ 94 w/100

Drlg. 1265

6-20

D & A

? 7070', ? 1838', K. C. 2193', B.K.C.

2413', Osw. 2445', ? 2502', Che 2644',

Miss. 2913', M. Lime 1934',

? 3246', A. 3315',

TD 3365'

ABANDONED

Date Comm. 5-25-56 CSO - DHM
8" @ 94/100 drlg. 1265

8" @ 94/100 drlg. 1265

CSO - DHM

FIRST REPORT

0

MAY 29 1959

JUN 5 1958

2.2

County Crowley Elev. 1393
 Sec. 3 Twp. 31 Rge. 6E
 Company W. L. Hartman
 Farm Name Crowley No. 1

TOPS	DEPTH	LOG	DATUM	Loc. in Sec.
Anh.				SE SE NW
Tr.				
Dg. <u>Top</u> ?	<u>7070</u>			
Bl. <u>Thief</u> ?	<u>1838</u>			
L.				Geol.
K.C.	<u>2193</u>			Contr.
B.K.C.	<u>2413</u>			Co. tools
Ce. <u>Dark OSW.</u>	<u>2445</u>			Pool
C. <u>Mass</u> ?	<u>2502</u>			Wildcat
M. <u>Cher.</u>	<u>2644</u>			ABANDONED
M. <u>Miga</u>	<u>2913</u>			
K. <u>M. L.</u>	<u>1934</u>			
Mz. <u>and</u> ?	<u>3246</u>			
Mo.				
V.				
S.				
S.				
A.	<u>2315</u>			
R.				
Pe.				
G.				
T.D.	<u>3365</u>			JUN 20 1956

Date Comm. 5-25-56 CSO - DHM

8" @ 94/100 drl. 1265 JUN 6 '56

Ø 3176 JUN 13 '56

D. & A W. L. Hartman JUN 20 '56