


Section 36 Township 18 Range 11W

Well No. #4 Doll

Company Sohio

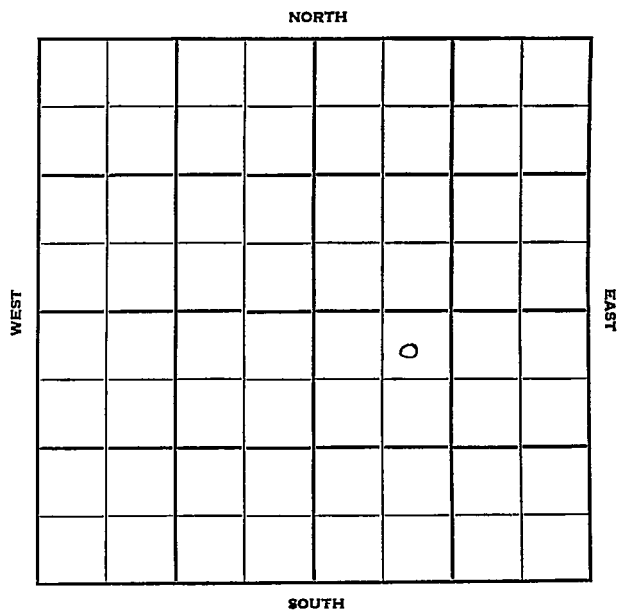

Barton

KANSAS

Sec. 36 Twp. 18 R. 11W

Well No. #4 Doll Farm

Sohio Company

Penguin - Contr. Contractor

Mary Ida


330' Ft. from N. Line

\_\_\_\_\_ Ft. from S. Line

\_\_\_\_\_ Ft. from E. Line

990' Ft. from W. Line

NE NW SE

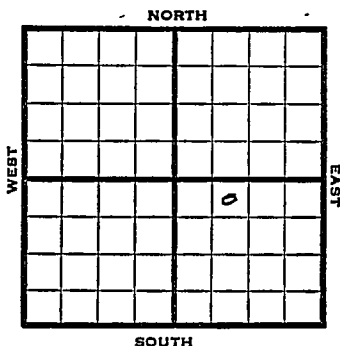

1952

Elev. 1751' REPORT

1/23 RUR  
2/6  $\phi$  8" @ 302'  
Anhy 485 Topeka 2559 Heeb. 2818  
Br Li 2938 Lans 2955  
DST 3015-33,  $\frac{1}{2}$  hr. 100' O&GCM  
DST 3040-47,  $\frac{1}{2}$  hr. 210' HO&GCM  
Drlg. 3045'

2/13 B KC 3218' Gong. 3244' Arb. 3270-76  
TD. 5" @ 3272' GO to 3239'  
20/3043-47 Test 22 gal oil plus  
1 gal wtr for 2 hrs. 1000 A  
F/125 BO 8 hr.

2/20 Spud 1-24-52  
Oil well TD 3276' 8" @ 302  
Anhy 485' Top. 2551' Heeb 2818'  
Br. lime 2938' Lans. 2955'  
DST 3015-33 open  $\frac{1}{2}$  hr. rec 100' O &  
GCM  
DST 3040-47 open  $\frac{1}{2}$  hr. rec 210' HO  
& GCM.  
B KC 3218' Gong. 3244' Arb. 3270'  
TD 3276' 5" @ 3272' GO to 3239'  
20/3043-47 22 GO 1 GWPH 1000 A  
F/125 BO 8 hr.  
Comp. F/517 BOPD

COMPLETED



