

KANSAS


Barton

Form 51-5M-7-40-Palace

Section 36 Township 18 Range 11-W

Well No. #1 Dutton

Company Lauck & Moncrief

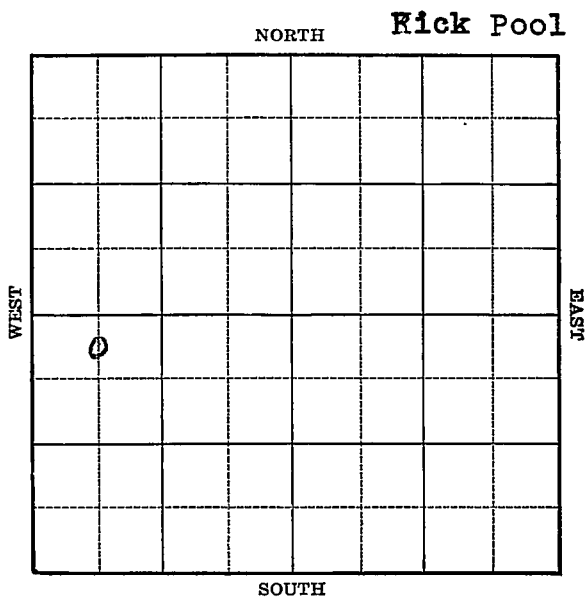

KANSAS


Barton

Sec. 36 Twp. 18 R. 11-WWell No. #1 Dutton FarmLauck & Moncrief Company

(Rick)

330 Ft. from N. Line Ft. from S. Line Ft. from E. Line660 Ft. from W. Line

Elev. 1752

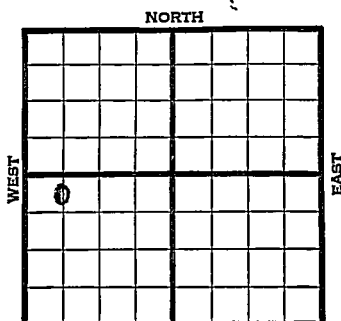

1941

REPORT

4/2 10" - 98' WOC.

4/10 Anhy 50 5' Drlg. 2190'

4/18 Lansing 2985 Arb. 3346-65 TD

Run 5" No shows

4/18 Preparing to drill plugs (Tel)

Running 1' lower on Arbuckle than Lauck & Moncrief #1 Doll dry hole CSL SW SE 36-18-11W (Frost)

4/21 Lansing 2985 Show oil 3125-32 ~~XXSXXS~~

Show oil 3139-65 Arbuckle 3346-65

TD 3365 To run 5" above Arbuckle and test Lansing (Tel)

4/24 5" - 3244' Drilled out to 3226' 65 shots 3183-98'

48 " 3122-32' 2000 acid.

Testing.

4/25 Swab 127½ bbls. oil 5½ hours

2000 gallons acid Did not help

Swab 106 bbls. oil in 5 hrs. (Tel)

Running tubing & rods to take potential

5/1 Pump 17 bbls. oil per hour for 17 hours.

5/8 " " " OVER

1941

5/15 48 shots 3122-32' 2000 acid.
Pump 17 bbls. oil per hour for
17 hours.

5/22 " " "

5/28 " " "

6/5 " " "

6/12 " " "

6/19 " " "

6/25 Lans. 2985'
Arb. 3346'
5" - 3244'
T.D. 3365'
Drilled cement to 3226'
65 shots 3183-98'
48 shots 3122-32'
5000 acid.
Pump 123 oil plus 5% water.
35. Gravity

COMPLETED

Map No. 55 Sec. 36 Twp. 18 R. 11WWell No. 1 DuttonLauck & Moncrief CompanyFIRST REPORT Contractor

C N L NW SW

330 Ft. from N. Line Ft. from S. Line Ft. from E. Line660 Ft. from W. Line

RICK POOL

SECTION PLAT

o			

Location Rig up

Drilling and Remarks:

10" - 98

WOC

RECORD

Cased in., ft.Sand Gas Oil Total Depth

PRODUCTION

1st 24 hrs. Nat. 1st 24 hrs. after shot Gas Cu. Ft.Dry Hole Abandoned

Date

APR 2 1941₁₉S. J. LEWIS Scout

Map No. _____ Sec. 36 Twp. 18 R. 11WWell No. 1 DuttonLauck & Moncrief Company**COMPLETED**

Contractor

SECTION PLAT

C N L NW SW

330 Ft. from N. Line

_____ Ft. from S. Line

_____ Ft. from E. Line

660 Ft. from W. Line

Rick Pool

Location _____

Rig up _____

Drilling and Remarks:

Leave 2985
 Cor & 3346
 5" @ 3244
 Drill col @ 3226
 65 Shot 3188-98
 48 " 3122-32
 5000 @ 3216
 Pump 123 oil + 500 water
 382 Gr.

RECORD

Cased _____ in., _____ ft.

Sand _____

Gas _____

Oil _____

Total Depth 3365

PRODUCTION

1st 24 hrs. Nat. _____

1st 24 hrs. after shot _____

Gas _____ Cu. Ft.

Dry Hole _____

Abandoned _____

Date

JUN 25 1941 19S. J. LEWIS Scout